IREDELL COUNTY HEALTH DEPARTMENT

STATESVILLE 704-878-5305 (a) MOORESVILLE 704-664-5281

IMPROVEMENT PERMIT / AUTHORIZATION TO CONSTRUCT / OPERATION PERMIT / EXISTING SYSTEM INSPECTION

PERMIT# 115529 PIN# 4863-20-8643 DATE 9-24-03

OWNER OR CONTRACTOR TIMOTHY SOUTHER PHONE: Business _____ Home 336-468-4382

ADDRESS 4916 HUNTING CREEK CHURCH RD HAMPTONVILLE, NC 27020

LOCATION 901, (L) WINTHROP, (L) CRATER (R) (MOONLIGHT), (L) AARON (R) VANDERLEE, PAST CURVE ON RT

SUBDIVISION _____ BLOCK / SECTION _____ LOT _____ LOT AREA 3.87 AC SITE CLASS. PS DESIGN FLOW 360 L.T.A.R. .3

Septic Tank: 1000 Gallons; STB 1012 Date 6-9-03
Pump Tank: _____ Gallons; PT _____ Date _____
Pump Make: _____ Model _____ Serial No. _____
Nitrification Field: No Fields 1 Square Feet 1200' Linear Feet 400'
No Lines 3 x 133' Trench Width 36" Max Trench Bottom Depth 36" Gravel Depth 12"


☒ New System ☐ Repair System Type: I, (II), III, IV, V, VI
System Description: CONV GRAV
Repair System Description: SAME
Maintenance Agreement Required: ☐ Yes ☐ No

☒ House/Mod. Home No. Bedrooms 3
☐ Mobile Home No. Bathrooms 2
☐ Business No. Employees ____
☐ Other _____
☐ Slab ☐ Crawl Space ☐ Basement w/plumbing ☒ Basement wo/plumbing


Water Supply: ☒ Individual ☐ Public ☐ Community

Comments/Conditions: (1) FROM PT A TO PT B THERE IS 10' OF ELEVATION DIFFERENCE FOR BASEMENT CUT TO DAYLIGHT. THIS TOTAL DISTANCE IS 110' OR 80' FROM BACK OF HOUSE / BASEMENT. (2) DO NOT CUT EXCESSIVELY FOR BASEMENT! AFTER CLEARING & BY DIGGING BEGINS CALL FOR A CONSULTATIVE VISIT. (3) INSTALL LINES ON CONTOURS & MAINTAIN SETBACKS. (4) KEEP SYSTEM 100' FROM ANY WELL, THIS INCLUDES THE REPAIR AREA.

INITIAL SITE SKETCH

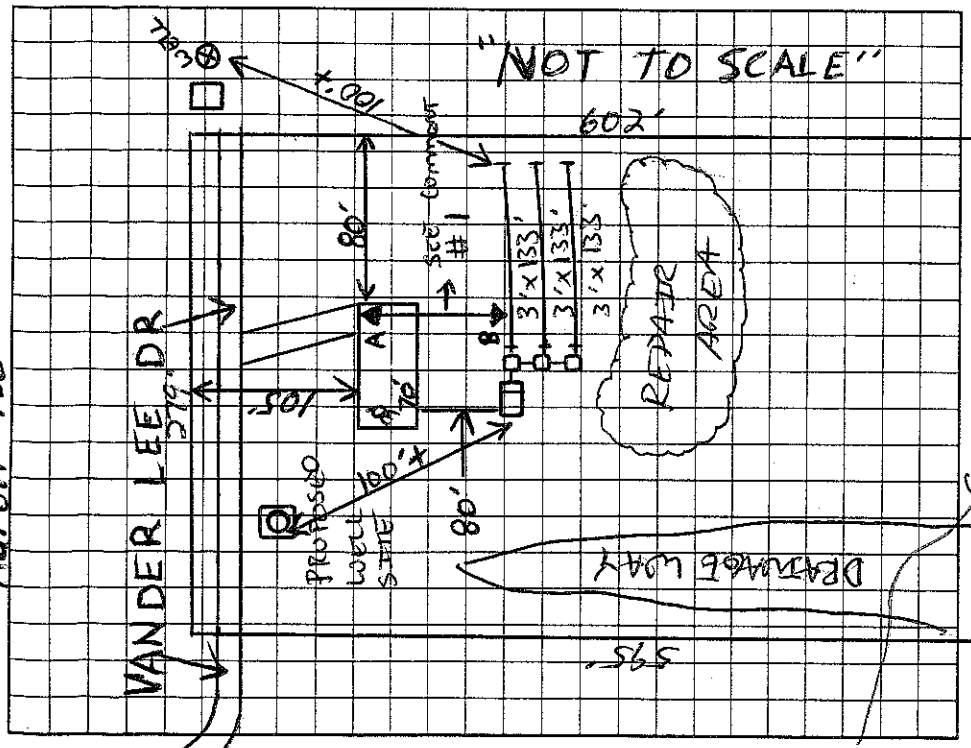

AS BUILT SKETCH

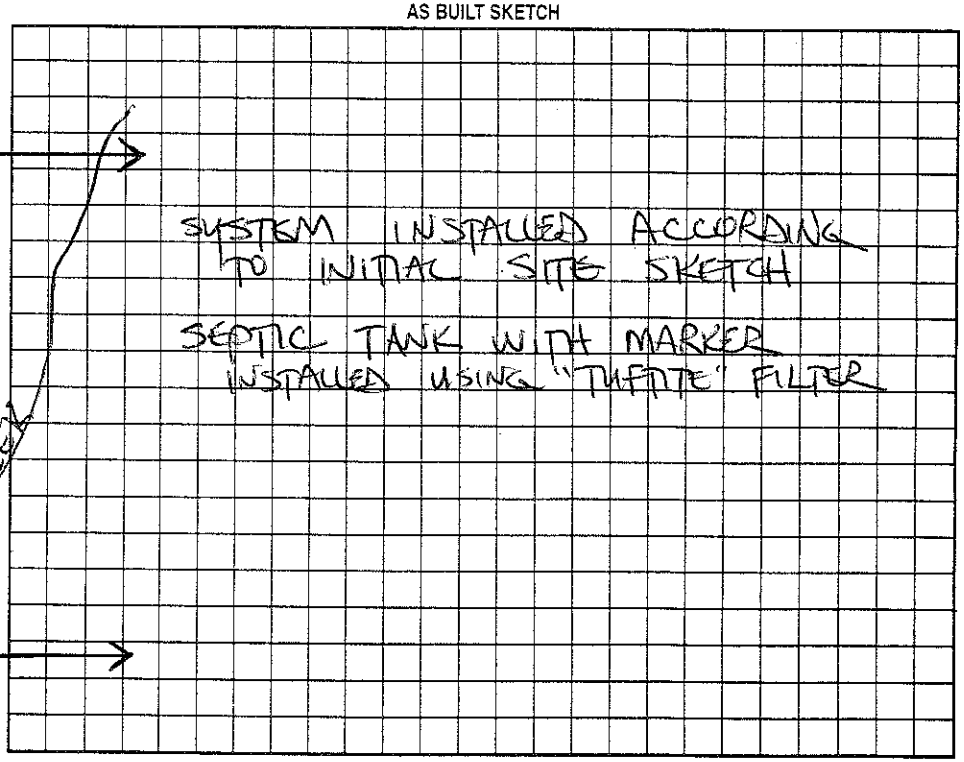

Permit can be suspended or revoked if any false information is supplied toward securing the permit/any unauthorized changes are made to the site/any unauthorized changes are made in the installation of the system. Improvement ~~Permit with plat~~ valid without expiration. Improvement ~~Permit with site plan~~ valid for sixty months. Authorization to Construct is valid for a period equal to that of Improvement Permit – not to exceed sixty months.

Signed: Tim Souther date _____ Installed by: CRAIG THOMPSON

Improvement Permit by: [signature] RS date 9-24-03 Operation Permit by: STEVE HENDRICK date 11-25-03

Authorization to Construct by: [signature] RS date 9-24-03 Existing System Inspection by: _____ date _____

HEALTH DEPT. COPY: WHITE OWNER COPY (FINAL): YELLOW OWNER COPY (INITIAL): PINK