2:00

IREDELL COUNTY HEALTH DEPARTMENT

STATESVILLE 704-878-5305 (ad) (R) MOORESVILLE 704-664-5281 RA

IMPROVEMENT PERMIT / AUTHORIZATION TO CONSTRUCT / OPERATION PERMIT / EXISTING SYSTEM INSPECTION

PERMIT # 15939 PIN # 4863 208952 DATE 1-11-10

OWNER or APPLICANT Lyndon Souther PHONE: Business Home: 704-807-1052

OWNER or APPLICANT ADDRESS 140 Vandyfee RD Harmony NC 28634

LOCATION / DIRECTIONS 77 N Exit 65 (R) → (R) Winthrop (L) Crater (R) Fairbright (L) Hain (R) Vandyfee (140 Vandyfee)

SUBDIVISION BLOCK / SECTION LOT # 4 LOT AREA 3.47 DESIGN FLOW 360 L.T.A.R. .25

Septic Tank 1000 Gallons: STB 760 Date 3-3-10
Pump Tank Gallons: P T Date
Pump Make Model Serial #
Nitrification Field No Fields No Lines 3 Linear Feet 360
Trench Width 36 Max. Trench Bottom Depth 36" Gravel Depth NA

☑ New System ☐ Repair ☐ Expansion System Type I II (III) IV V VI
System Description: 25% Gravity
Repair System Description: 25% Gravity
Maintenance Agreement Required ☐ YES ☑ NO
☑ GRAVITY ☐ PRESSURE

☑ Residence No. Bedrooms 3
☐ Business No. Persons
☐ Other No. Employees
☐ Slab ☐ Crawl Space
☑ Basement w/plumbing ☐ Basement w/o plumbing

Water Supply: ☑ Private ☐ Public ☐ Community

Comments / Conditions


* Must Use Drop Boxes

Comments / Conditions

Install on Contour
Maintain all setbacks


Public/Loc Follow plan when installed.

INITIAL SITE SKETCH

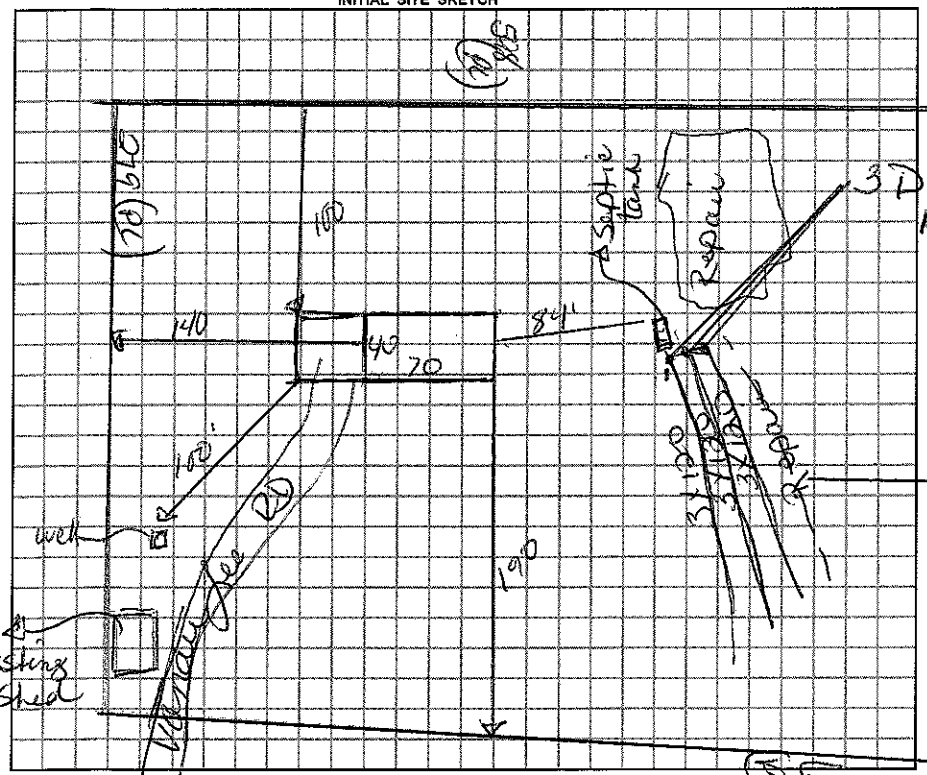

AS BUILT SKETCH

Not to SCALE

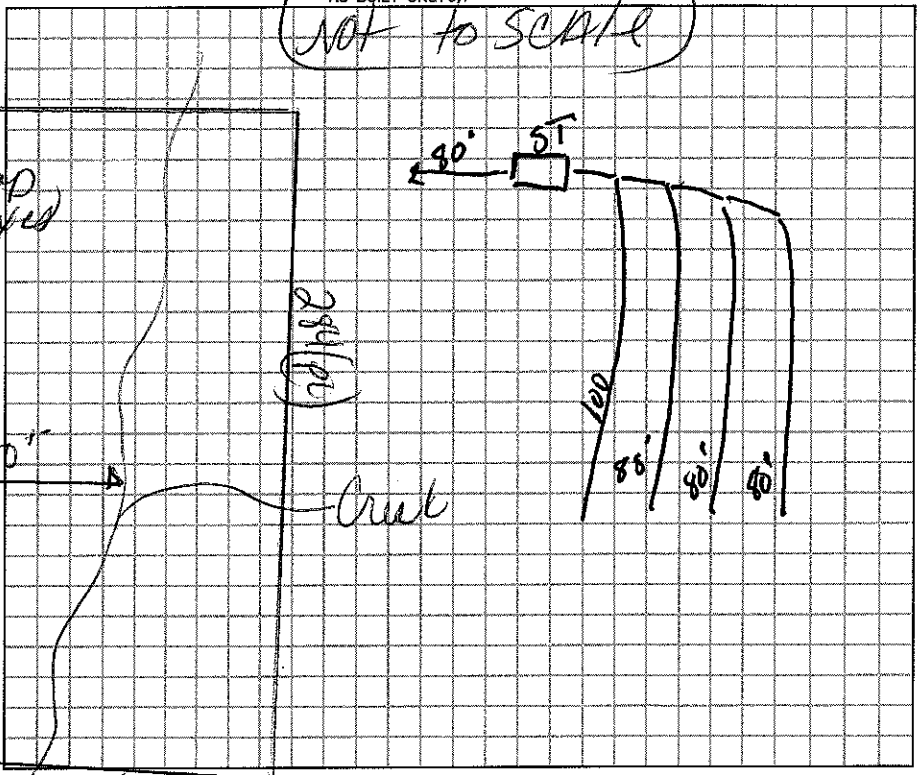

Permit can be suspended or revoked if any false information is supplied toward securing the permit / any unauthorized changes are made to the site / any unauthorized changes are made in the installation of the system.

☐ IMPROVEMENT PERMIT w / plat valid without expiration. ☑ IMPROVEMENT PERMIT w / site plan valid for 60 mos. ☑ AUTHORIZATION TO CONSTRUCT valid for period equal to IMPROVEMENT PERMIT-not to exceed 60 mo.

Owner / Applicant Signature: Lyndon Souther Date 1-13-10

Improvement Permit by: Doug Cook Date 1-11-10

Authorization to Construct by: Doug Cook Date 1-11-10

YOU SHOULD CONTACT A LOCATOR SERVICE PRIOR TO ANY EXCAVATION.

Installed by: A-1

Operation Permit by: J. Hyatt R.S. Date: 11 Aug. 10

Existing System Inspected by: Date:

WHITE COPY Environmental Health YELLOW COPY (Final) Owner / Applicant PINK COPY (Initial) Owner / Applicant