IREDELL COUNTY HEALTH DEPARTMENT

STATESVILLE 704-878-5305 MOORESVILLE 704-664-5281

IMPROVEMENT PERMIT / AUTHORIZATION TO CONSTRUCT / OPERATION PERMIT / EXISTING SYSTEM INSPECTION

PERMIT# 091086 PIN# 486 32 35 118 DATE August 3, 2000

OWNER OR CONTRACTOR Matthew Brown PHONE: Business Home 539-9479

ADDRESS 333 Triviette Road

LOCATION I77 N TR901 (East) TL Harmony Eagle Mills TL Triviette ~ 3/4 mile on left

SUBDIVISION BLOCK / SECTION LOT LOT AREA SITE CLASS PS DESIGN FLOW 480gpd L.T.A.R. .3-.4

Septic Tank: Ex- 1000 Gallons; STB Date

Pump Tank: Gallons; PT Date

Pump Make: Model Serial No.

Nitrification Field: No Fields 1+Ex Square Feet 600 Linear Feet 200

No Lines 3 Trench Width 36" Max Trench Bottom Depth 36"

☐ New System ☑ Repair System Type: I, II, III, IV, V

System Description: Upgrade GRAVITY INNOVATIVE - 25% Reduction

Repair System Description: GRAV. INNOVATIVE

Maintenance Agreement Required: ☐ Yes ☑ No

Gravel Depth N/A

☑ House/Mod. Home ☐ Mobile Home ☐ Business ☐ Other


No. Bedrooms 4 No. Bathrooms 2 No. Employees

Slab ☑ Crawl Space ☐ Basement w/plumbing ☐ Basement wo/plumbing

Water Supply: ☑ Individual ☐ Public ☐ Community

Comments/Conditions: If property is subdivided in future then property line needs to be 10' from closest point (end) of new septic laterals or an easement will be needed. Upgrade from 2BR to 4BR capacity.

INITIAL SITE SKETCH

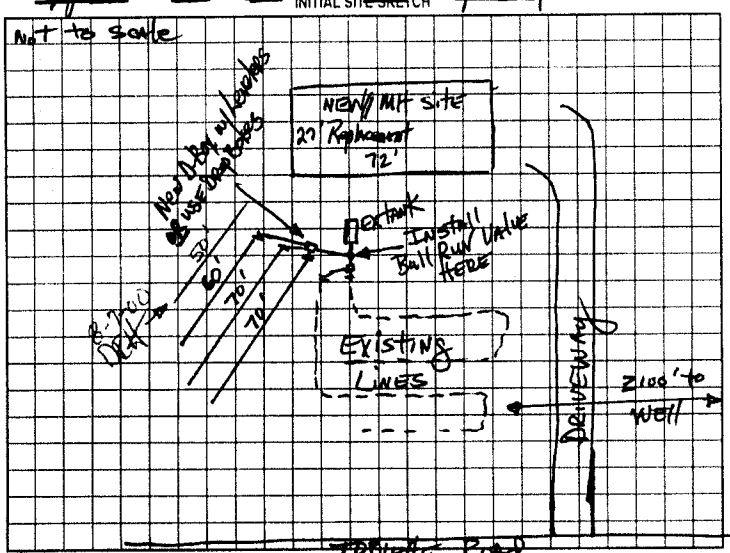

Comments/Conditions: E- 7-00 At request of owner and due to cost permission is granted to use 250' of conventional gravel type trenches on lieu of the 200' Innovative shown. Use a 4th trench approx 50' in length and also use drop boxes from Ball Run Valve. DHoffman

AS BUILT SKETCH

SYSTEM INSTALLED ACCORDING TO INITIAL SITE SKETCH USING DISTRIBUTION BOX INSTEAD OF BALL-RUN VALVE

Permit can be suspended or revoked if any false information is supplied toward securing the permit/any unauthorized changes are made to the site/any unauthorized changes are made in the installation of the system. Improvement Permit with plat valid without expiration. Improvement Permit with site plan valid for sixty months. Authorization to Construct is valid for a period equal to that of Improvement Permit – not to exceed sixty months.

Signed: Matthew Brown date 8-3-00

Improvement Permit by: DHoffman date 8-3-00

Authorization to Construct by: DHoffman date 8-3-00

Installed by: Tommy Frye

Operation Permit by: STEVE HORKK date 12-11-00

Existing System Inspection by: date

HEALTH DEPT COPY WHITE OWNER COPY (FINAL) YELLOW OWNER COPY (INITIAL) PINK