2ND HOUSE ON LEFT

IREDELL COUNTY HEALTH DEPARTMENT

STATESVILLE 704-878-5305 MOORESVILLE 704-664-5281

IMPROVEMENT PERMIT / AUTHORIZATION TO CONSTRUCT / OPERATION PERMIT / EXISTING SYSTEM INSPECTION

PERMIT# 113269 PIN# 4863-24 ~~4863~~ 5005 DATE 6-20-03

OWNER OR CONTRACTOR JOHN & ANGEL BUCHANAN PHONE: Business Home 704-539-4373

ADDRESS 664 W. HOUSTONVILLE ROAD, HARMONY, NC 28634

LOCATION I-77 N, TL NC 901, TR MULLIS ROAD, AT END TR MULLIS RD, LAST TRACT ON RIGHT AT TRIVETTE ROAD

SUBDIVISION _____ BLOCK / SECTION _____ LOT _____ LOT AREA 1.955 ACRES SITE CLASS. PS DESIGN FLOW 360 L.T.A.R. 0.30 gpd/ft²

Septic Tank: 1000 Gallons; STB 1012 Date 3-9-03
Pump Tank: _____ Gallons; PT _____ Date _____
Pump Make: _____ Model _____ Serial No. _____
Nitrification Field: No Fields 1 Square Feet 1200 Linear Feet 400
No Lines FOUR Trench Width 36" Max Trench Bottom Depth 36" Gravel Depth 12"

☑ New System ☐ Repair System Type: I, II, III, IV, V, VI
System Description: CONVENTIONAL GRAVITY
Repair System Description: ~~CONVENTIONAL GRAVITY~~
Maintenance Agreement Required: ☐ Yes ☑ No


☑ House/Mod. Home No. Bedrooms 3
☐ Mobile Home No. Bathrooms 2
☐ Business No. Employees _____
☐ Other _____
☐ Slab ☑ Crawl Space ☐ Basement w/plumbing ☐ Basement wo/plumbing

Water Supply:
☑ Individual
☐ Public
☐ Community
WELL


Comments:/Conditions: KEEP SYSTEM MINIMUM 100 FEET FROM WELL, 50' FROM CREEK PROPERTY LINE 407.19'

Comments:/Conditions: WELL MOVED DOWN 13' FROM ORIGINAL PLACE, OWNER MARKED P/L'S. REPAIR CHANGED FROM CONV. GRAV TO KP PANEL WITH JOHN BUCHANAN'S PERMISSION. (RCS)

INITIAL SITE SKETCH

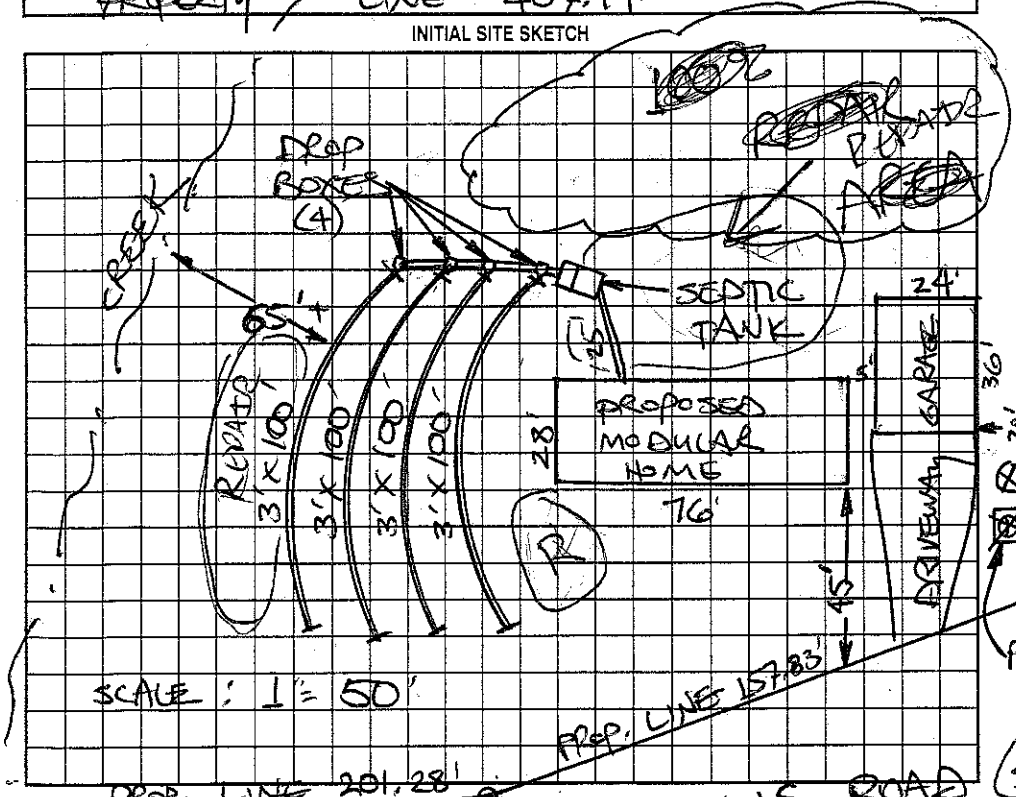

AS BUILT SKETCH

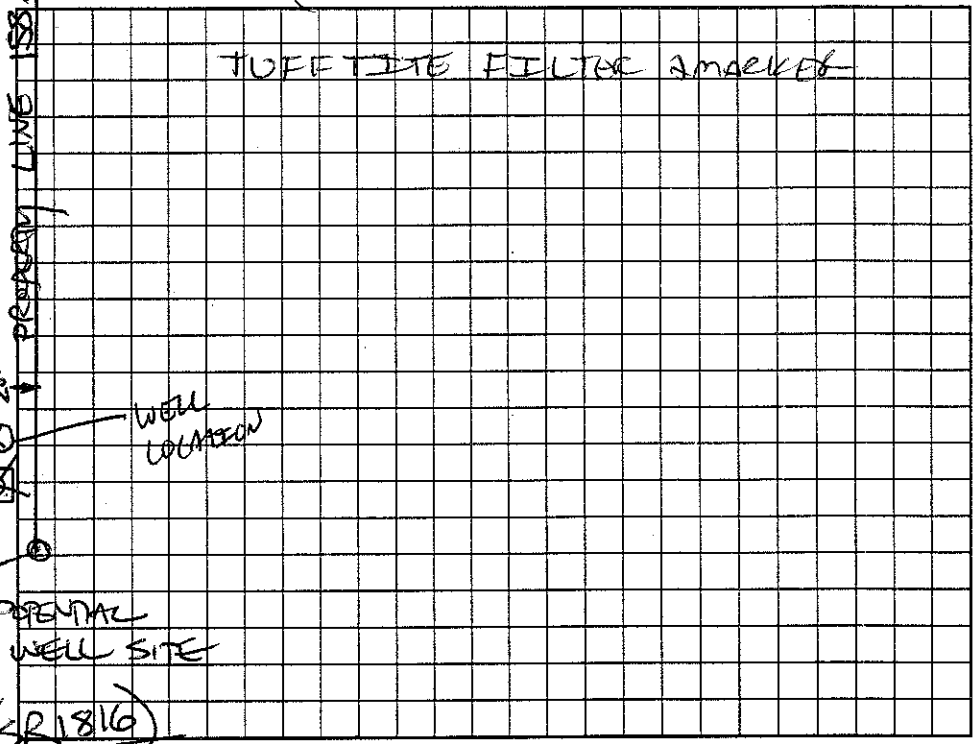

Permit can be suspended or revoked if any false information is supplied toward securing the permit/any unauthorized changes are made to the site/any unauthorized changes are made in the installation of the system. Improvement Permit with plat valid without expiration. Improvement Permit with siteplan valid for sixty months. Authorization to Construct is valid for a period equal to that of Improvement Permit – not to exceed sixty months.

Signed: X JB Buchanan date 6-20-03 Installed by: A-1 BACKHOE

Improvement Permit by: STEVE HEDRICK date 6-20-03 Operation Permit by: _____ date 10-14-03

Authorization to Construct by: STEVE HEDRICK date 6-20-03 Existing System Inspection by: _____ date _____

HEALTH DEPT. COPY: WHITE OWNER COPY (FINAL): YELLOW OWNER COPY (INITIAL): PINK