IREDELL COUNTY HEALTH DEPARTMENT

STATESVILLE 704-878-5305 MOORESVILLE 704-664-5281

IMPROVEMENT PERMIT / AUTHORIZATION TO CONSTRUCT / OPERATION PERMIT / EXISTING SYSTEM INSPECTION

PERMIT# 077491 PIN# 4863 30 1026 DATE 11-3-98

OWNER OR CONTRACTOR DEBBIE MURPHY PHONE: Business Home

ADDRESS 124 WINDFOREST DR. STATESVILLE NC 28677

LOCATION I-77 N TR NC901, TL CRATER, TR CARTWRIGHT, TL CHESHIRE RIDGE ROAD, 8TH LOT ON LEFT

SUBDIVISION CHESHIRE RIDGE BLOCK / SECTION II LOT 29 LOT AREA 2.32 ACRES SITE CLASS PS DESIGN FLOW 360 L.T.A.R. 0.30 GPD/FT²

Septic Tank: 1000 Gallons: STB 794 Date 10-20-98

Pump Tank: Gallons: PT Date

Pump Make: Model Serial No.

Nitrification Field: No Fields 1 Square Feet 1200 Linear Feet 400

No Lines FIVE Trench Width 36" Max Trench Bottom Depth 30" Gravel Depth 12"

☑ New System ☐ Repair System Type: I, II, III, IV, V, VI

System Description: CONVENTIONAL GRAVITY

Repair System Description: CONV. GRAVITY

Maintenance Agreement Required: ☐ Yes ☑ No

☐ House/Mod. Home ☑ Mobile Home ☐ Business ☐ Other

No. Bedrooms 3 No. Bathrooms 2 No. Employees


Water Supply: ☑ Individual ☐ Public ☐ Community WELL

☐ Slab ☑ Crawl Space ☐ Basement w/plumbing ☐ Basement wo/plumbing


Comments:/Conditions: ① KEEP SYSTEM MINIMUM 100' FROM WELL ② INSTALL SUBSURFACE INTERCEPT DRAINAGE DITCH AT LOCATION SHOWN BEGINNING 42" DEEP OUT TO DAYLIGHT

Comments:/Conditions: SYSTEM CHECKED 12-9-98 SUBSURFACE INTERCEPT DRAINAGE DITCH REMAINS TO BE INSTALLED

SCALE: 1"=50' INITIAL SITE SKETCH

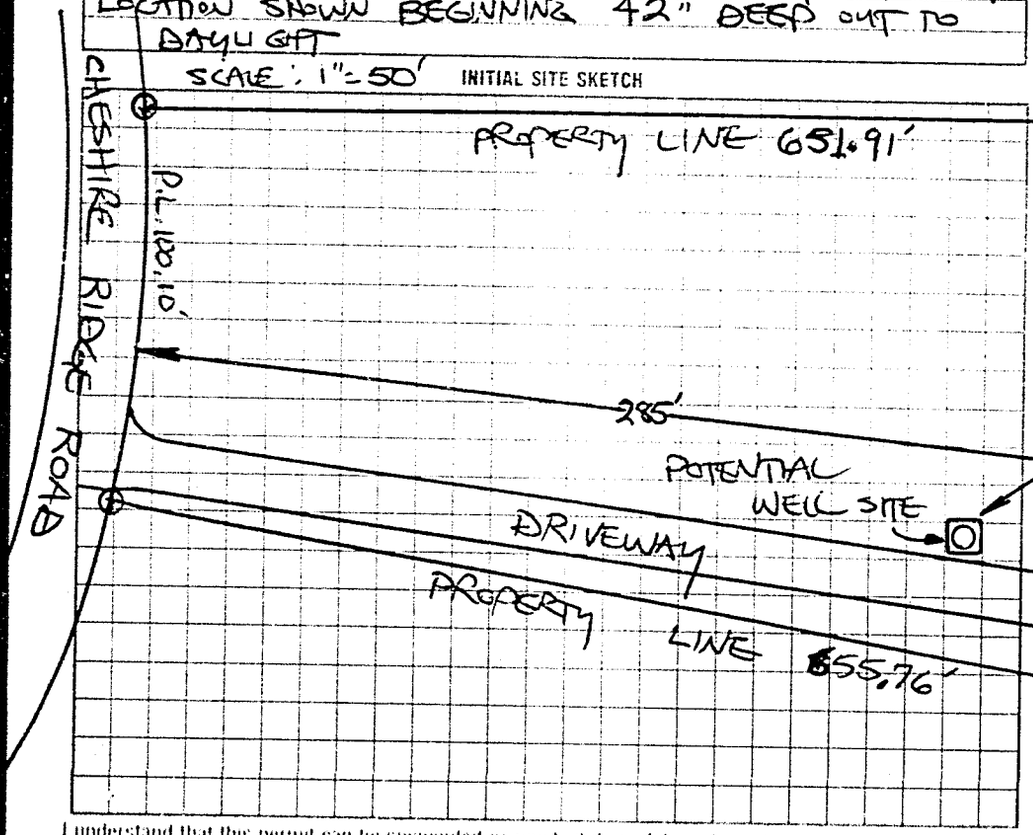

AS BUILT SKETCH

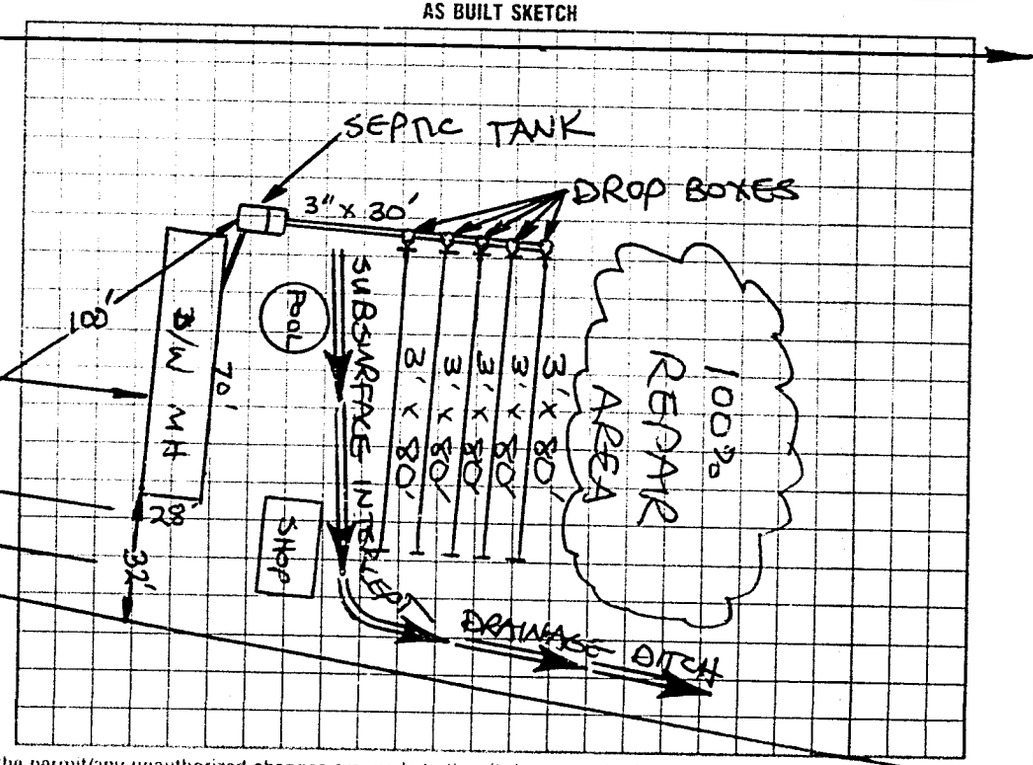

I understand that this permit can be suspended or revoked if any false information is supplied toward securing the permit/any unauthorized changes are made to the site/any unauthorized changes are made in the installation of the system. Improvement Permit with plat valid without expiration. Improvement Permit with site plan valid for sixty months. Authorization to Construct is valid for a period equal to that of Improvement Permit – not to exceed sixty months.

Signed: Claudette Bullard date 11-5-98

Improvement Permit by: STEVE HEDRICK date 11-3-98

Authorization to Construct by: STEVE HEDRICK date 11-3-98

Installed by: JAMES HUDLER

Operation Permit by: STEVE HEDRICK date 12-10-98

Existing System Inspection by: date

HEALTH DEPT. COPY WHITE INSPECTION COPY (FINAL) GREEN OWNER COPY (FINAL) YELLOW INSPECTION COPY (INITIAL) PINK OWNER COPY (INITIAL) GOLD

8 7 8 2 0 0