IREDELL COUNTY HEALTH DEPARTMENT

Statesville Office (704) 878-5305 Mooresville Office (704) 660-3625 PERMIT # 181285

IMPROVEMENT PERMIT / AUTHORIZATION TO CONSTRUCT / OPERATION PERMIT / EXISTING SYSTEM

PIN # 4863301026

APPLICANT: Jose Reyes APPLICANT ADDRESS: 1105 G. Memorial Hwy

SITE ADDRESS: 149 Cheshire Ridge Rd. PHONE: 301-741-1792 ALT. PHONE: N/A

SITE DIRECTIONS: I-77 N to exit #65 TR Hwy 90 TL Winthrop TL Crater TR Cartright TL Cheshire Ridge Rd.


SUBDIVISION: Cheshire Ridge Dr. SECTION: N/A LOT # 29 LOT AREA: 2.32 acres DESIGN FLOW: 360gpd L.T.A.R.: Existing

Septic Tank	Existing (gal)	STB		Date		☐ New System	☐ Repair	☐ Expansion	System Type: ☑ I ☐ II ☐ III ☐ IV ☐ V ☐ VI	☑ Residence	No. Bedrooms	3	Water Supply
Pump Tank	(gal)	PT		Date		System Description:	Conventional			☐ Business	No. Persons		☑ Private
Pump Make	Model			Serial #		Repair System Description:				☐ Other	No. Employees		☐ Public
# Nitrification Fields	1	# Lines	5	Linear Ft:	Ex	Maintenance Agreement Required:	☐ YES	☑ NO		☐ Slab	☑ Crawl Space		☐ Community
Trench Width	Ex	Max. Trench Bottom Depth	Ex	Gravel Depth	Ex		☑ GRAVITY	☐ PRESSURE		☐ Basement w/ plumbing		☐ Basement w/o plumbing	


Comments / Conditions:

- Maintain a minimum of 5' between mobile home & all components of septic tank system.

INITIAL SITE SKETCH

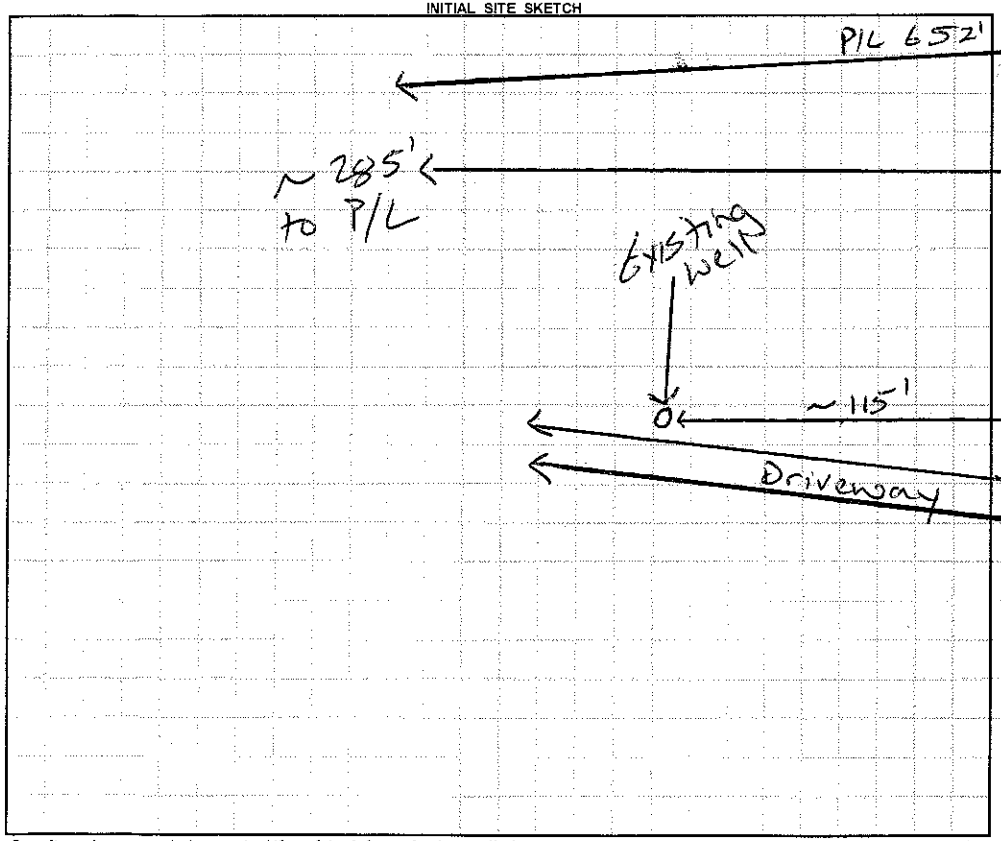

AS BUILT SKETCH

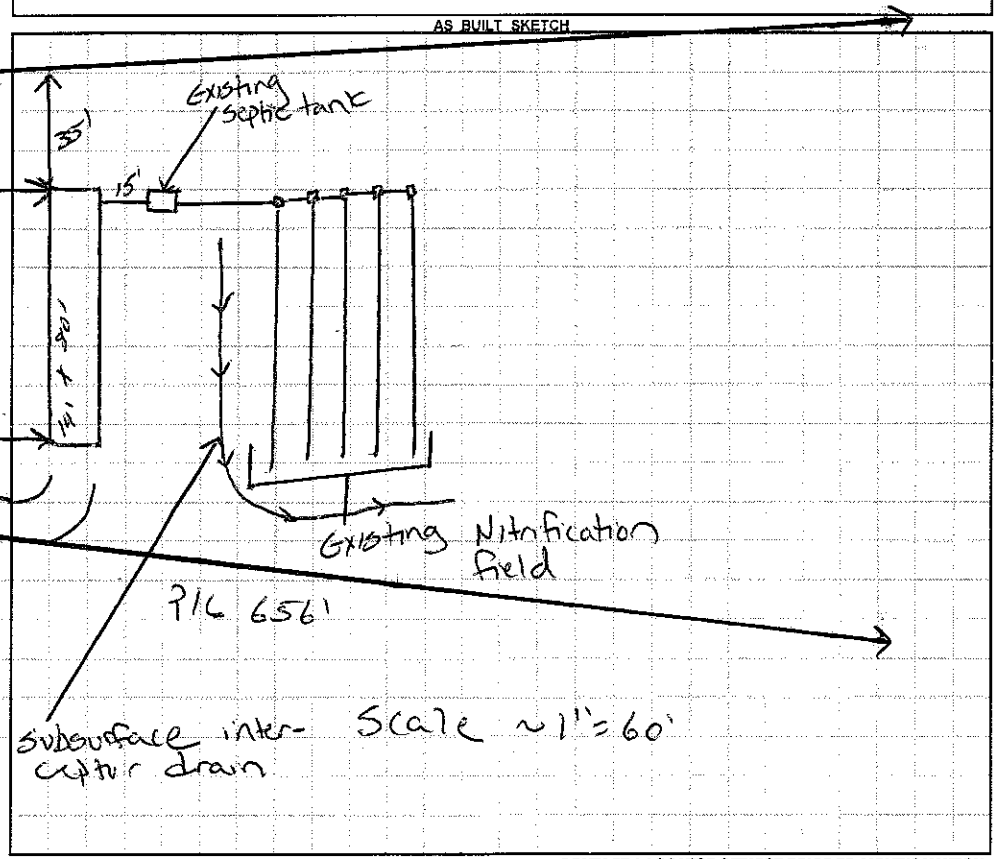

Permit can be suspended or revoked if any false information is supplied toward securing the permit / any unauthorized changes are made to the site / any unauthorized changes are made in the installation of the system. **CONTACT A LOCATOR SERVICE PRIOR TO ANY EXCAVATION**

☐ **IMPROVEMENT PERMIT** ***with plat*** *valid without expiration.* ☐ **IMPROVEMENT PERMIT** ***with site plan*** *valid for 60 mos.* ☐ **AUTHORIZATION TO CONSTRUCT** *valid for period equal to IMPROVEMENT PERMIT--not to exceed 60 mo.*

Owner / Applicant Signature: Jose Reyes Date: 10/16/13 Installed by:

IMPROVEMENT PERMIT by: Date: OPERATION PERMIT by: Date:

AUTHORIZATION TO CONSTRUCT by: Date: Existing System Inspected by: Justin Henderson Date: 10-14-13

Health Dept. Copy - WHITE Applicant (Final Approval) - YELLOW Applicant (Conditional Approval) - PINK