IREDELL COUNTY HEALTH DEPARTMENT

STATESVILLE 704-878-5305 MOORESVILLE 704-664-5281

IMPROVEMENT PERMIT / AUTHORIZATION TO CONSTRUCT / OPERATION PERMIT / EXISTING SYSTEM INSPECTION

PERMIT# 074951 PIN# 4862396188 DATE 7-24-98

OWNER OR CONTRACTOR RICHARD SMITH PHONE: Business Home 546-5260

ADDRESS P.O. BOX 475 HARMONY, NC 28634

LOCATION I-77N, TR NC 901, TL WINTHROP CH. RD, TL CRATER, TR CARTWRIGHT, TL CHESHIRE RIDGE,

SUBDIVISION CHESHIRE RIDGE BLOCK / SECTION LOT 30 LOT AREA 2.21 ACRES SITE CLASS PS DESIGN FLOW 360 L.T.A.R. 0.30 GPD/FT²

Septic Tank: 1000 Gallons; STB 1012 Date 5-27-98

Pump Tank: Gallons; PT Date

Pump Make: Model Serial No.

Nitrification Field: No Fields 1 Square Feet 1200 Linear Feet 400

No Lines FIVE Trench Width 36" Max Trench Bottom Depth 30" Gravel Depth 12"

☑ New System ☐ Repair System Type: I, II, III, IV, V, VI

System Description: CONVENTIONAL GRAVITY

Repair System Description: CONV. GRAVITY

Maintenance Agreement Required: ☐ Yes ☑ No

☐ House/Mod. Home No. Bedrooms 3

☐ Mobile Home No. Bathrooms 2

☐ Business No. Employees

☐ Other FUTURE 3BR


☐ Slab ☑ Crawl Space ☐ Basement w/plumbing ☐ Basement wo/plumbing

Water Supply: ☑ Individual ☐ Public ☐ Community WELL

Comments:/Conditions: (1) INSTALL LINES ON CONTOUR AS FLAGGED, NO DEEPER THAN 30" (2) KEEP SYSTEM MINIMUM 100' FROM WELL

Comments:/Conditions:

INITIAL SITE SKETCH SCALE: 1" = 40'

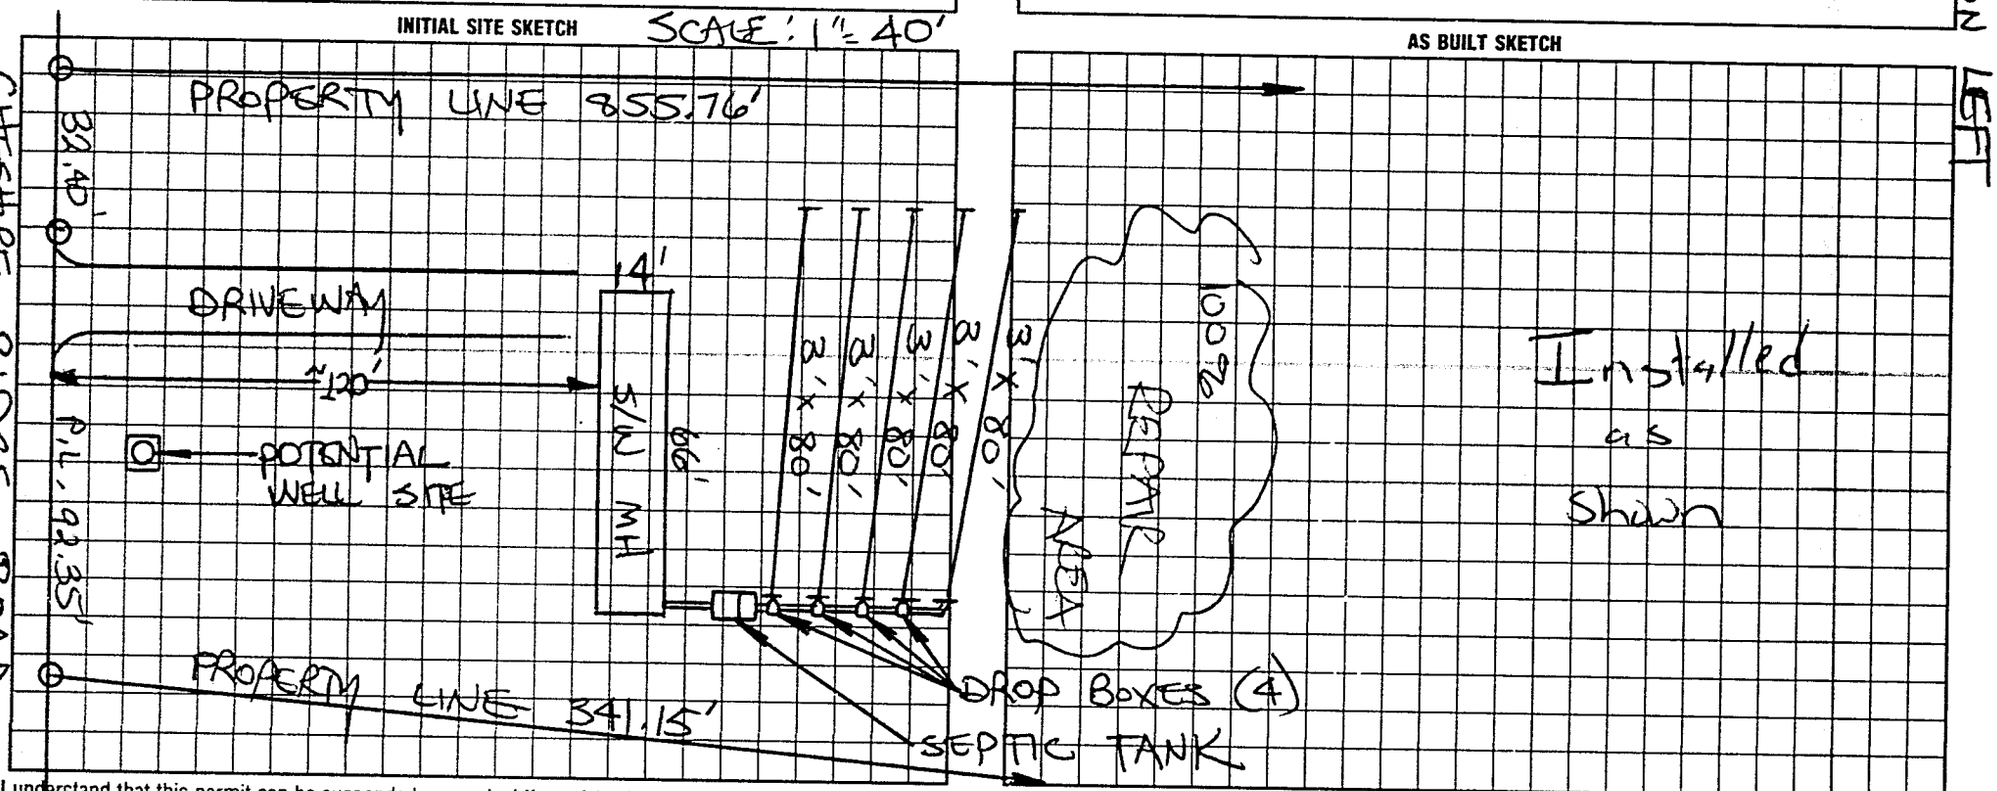

AS BUILT SKETCH

Installed as Shown

I understand that this permit can be suspended or revoked if any false information is supplied toward securing the permit/any unauthorized changes are made to the site/any unauthorized changes are made in the installation of the system. Improvement Permit with plat valid without expiration. Improvement Permit with site plan valid for sixty months. Authorization to Construct is valid for a period equal to that of Improvement Permit – not to exceed sixty months.

Signed: Richard Smith date 7-24-98

Improvement Permit by: STEVE HEDRICK date 7-24-98

Authorization to Construct by: STEVE HEDRICK date 7-24-98

Installed by: B. Galliher

Operation Permit by: [illegible] date 8-3-98

Existing System Inspection by: date

HEALTH DEPT COPY WHITE INSPECTION COPY (FINAL) GREEN OWNER COPY (FINAL) YELLOW INSPECTION COPY (INITIAL) PINK OWNER COPY (INITIAL) GOLD