IREDELL COUNTY HEALTH DEPARTMENT

STATESVILLE 704-878-5305 MOORESVILLE 704-664-5281

IMPROVEMENT PERMIT / AUTHORIZATION TO CONSTRUCT / OPERATION PERMIT / EXISTING SYSTEM INSPECTION

PERMIT# 075899 PIN# 4863 30 7349 DATE 9-28-98

OWNER OR CONTRACTOR MARY SOMERS PHONE: Business 878-9595 Home

ADDRESS 110 VILLAGE DRIVE STATESVILLE NC 28677

LOCATION I-77N, TR NC901, TL CRATER, TR CARTWRIGHT, TL CHESHIRE RIDGE, AT END ON LEFT

SUBDIVISION CHESHIRE RIDGE BLOCK / SECTION LOT 35 LOT AREA 1.42 ACRES SITE CLASS. PS DESIGN FLOW 360 L.T.A.R. 0.30 GPD/FT²

Septic Tank: 1000 Gallons; STB 1600 Date 9-30-98

Pump Tank: Gallons; PT Date

Pump Make: Model Serial No.

Nitrification Field: No Fields 1 Square Feet 1200 Linear Feet 400

No Lines FOUR Trench Width 36" Max Trench Bottom Depth 36" Gravel Depth 12"

☑ New System ☐ Repair System Type: I, II, III, IV, V, VI

System Description: CONVENTIONAL GRAVITY

Repair System Description: CONV. GRAVITY

Maintenance Agreement Required: ☐ Yes ☑ No

☐ House/Mod. Home ☑ Mobile Home ☐ Business ☐ Other

No. Bedrooms 3 No. Bathrooms 2 No. Employees


☐ Slab ☑ Crawl Space ☐ Basement w/plumbing ☐ Basement wo/plumbing

Water Supply: ☑ Individual ☐ Public ☐ Community WELL


Comments/Conditions: ① KEEP SYSTEM MINIMUM 100 FEET FROM WELL
② INSTALL SUBSURFACE INTERCEPT DRAINAGE DITCH BEGINNING 48" OUT TO DAYLIGHT

Comments/Conditions: SYSTEM INSTALLED ACCORDING TO INITIAL SITE SKETCH

INITIAL SITE SKETCH SCALE: ~1" = 50'

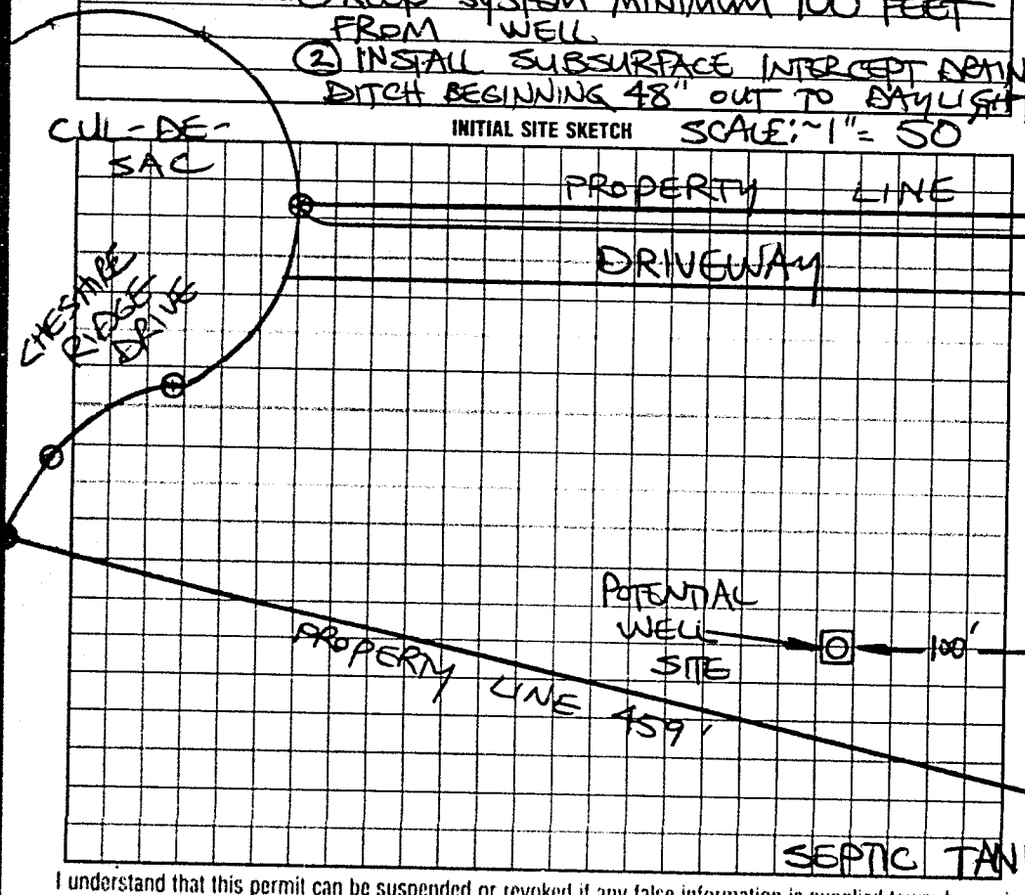

AS BUILT SKETCH

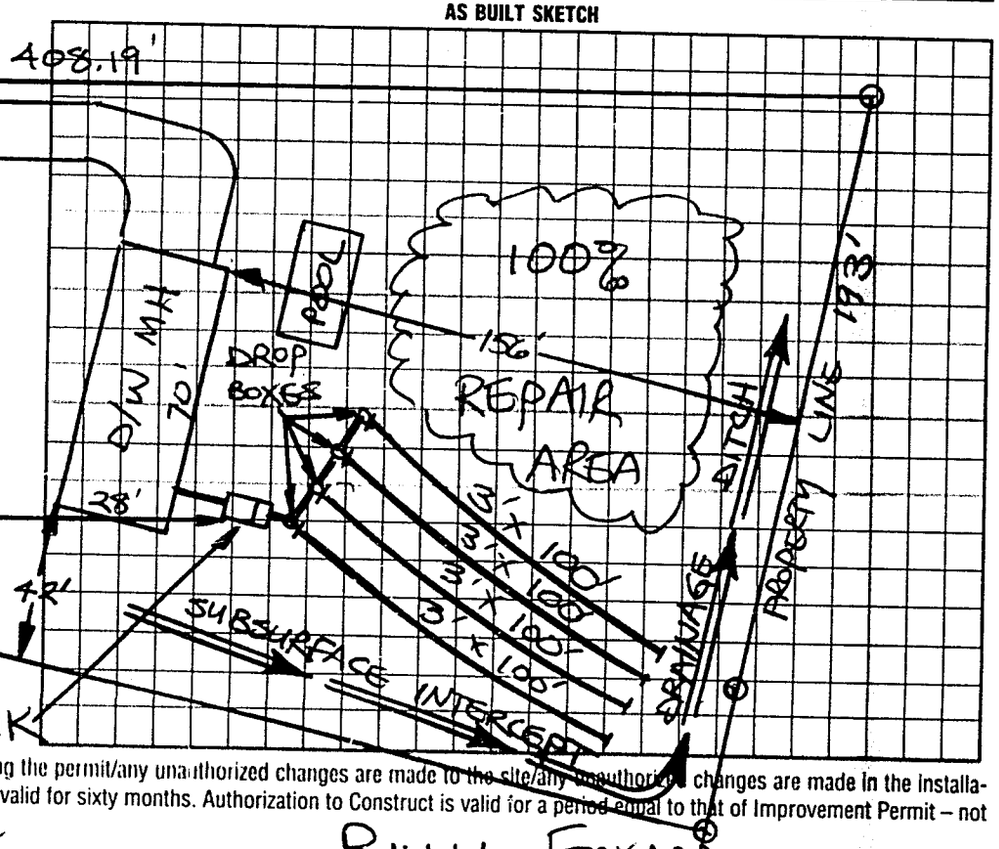

I understand that this permit can be suspended or revoked if any false information is supplied toward securing the permit/any unauthorized changes are made to the site/any unauthorized changes are made in the installation of the system. Improvement Permit with plat valid without expiration. Improvement Permit with site plan valid for sixty months. Authorization to Construct is valid for a period equal to that of Improvement Permit – not to exceed sixty months.

Signed: Jerry Michael Somers date 9-28-98

Improvement Permit by: STEVE HEDRICK date 9-28-98

Authorization to Construct by: STEVE HEDRICK date 9-28-98

Installed by: BILLY ECKARD

Operation Permit by: STEVE HEDRICK date 11-9-98

Existing System Inspection by: date

HEALTH DEPT COPY WHITE INSPECTION COPY (FINAL) GREEN OWNER COPY (FINAL) YELLOW INSPECTION COPY (INITIAL) PINK OWNER COPY (INITIAL) GOLD