IREDELL COUNTY HEALTH DEPARTMENT

STATESVILLE 704-878-5305 MOORESVILLE 704-664-5281

IMPROVEMENT PERMIT / AUTHORIZATION TO CONSTRUCT / OPERATION PERMIT / EXISTING SYSTEM INSPECTION

PERMIT# 095688 PIN# 4863 30 7507 DATE 5-2-01

OWNER OR CONTRACTOR FAUSTO C. AGUSTIN PHONE: Business (704) 535-4080 Home

ADDRESS c/o 2136 MELTON ROAD, CHARLOTTE, NC 28215

LOCATION I-77 N, TR NC 90L, TL CRATER RD, TR CARTWRIGHT RD TL CHESHIRE RIDGE RD LOT AT END ON RIGHT

SUBDIVISION CHESHIRE RIDGE BLOCK / SECTION II LOT 34 LOT AREA 2.05 ACRES SITE CLASS PS DESIGN FLOW 360 L.T.A.R. 0.30 GPD/FT²

Septic Tank: 1000 Gallons; STB 312 Date 5-12-01
Pump Tank: ____ Gallons; PT ____ Date ____
Pump Make: ____ Model ____ Serial No. ____
Nitrification Field: No Fields 1 Square Feet 1200 Linear Feet 400
No Lines FOUR Trench Width 36 Max Trench Bottom Depth 30" Gravel Depth 12"

☒ New System ☐ Repair System Type: (I) III. IV. V. VI
System Description: CONVENTIONAL GRAVITY
Repair System Description: 25% REDUCTION, AMP
Maintenance Agreement Required: ☐ Yes ☒ No
☐ Slab ☒ Crawl Space ☐ Basement w/plumbing ☐ Basement wo/plumbing


☐ House/Mod. Home No. Bedrooms 3
☒ Mobile Home No. Bathrooms 2
☐ Business No. Employees ____
☐ Other ____

Water Supply: ☒ Individual ☐ Public ☐ Community WELL


Comments/Conditions: (1) INSTALL SUBSURFACE INTERCEPT DRAINAGE DITCH AT LOCATION SHOWN BEGINNING 48" DEEP OUT TO DAYLIGHT (2) KEEP SYSTEM MINIMUM 100 FEET FROM WELL

Comments /Conditions: SEPTIC TANK WITH MARKER INSTALLED USING "ZABEL FILTER

INITIAL SITE SKETCH

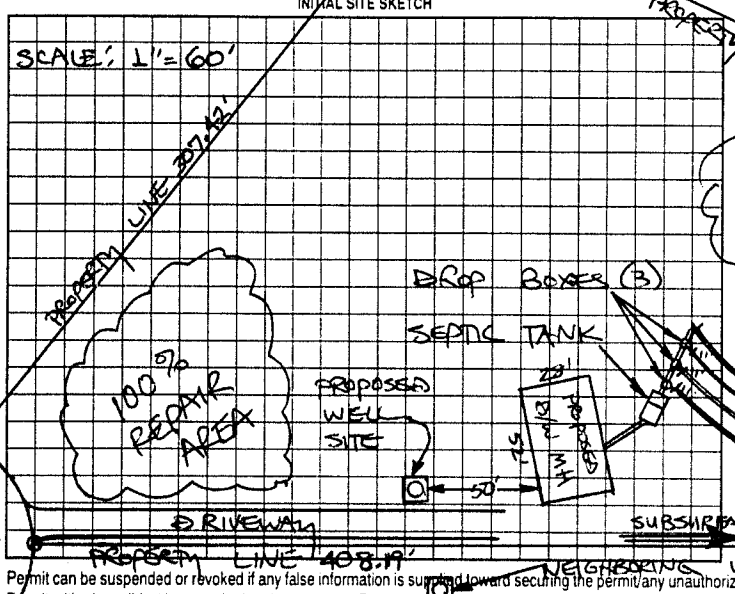

AS BUILT SKETCH

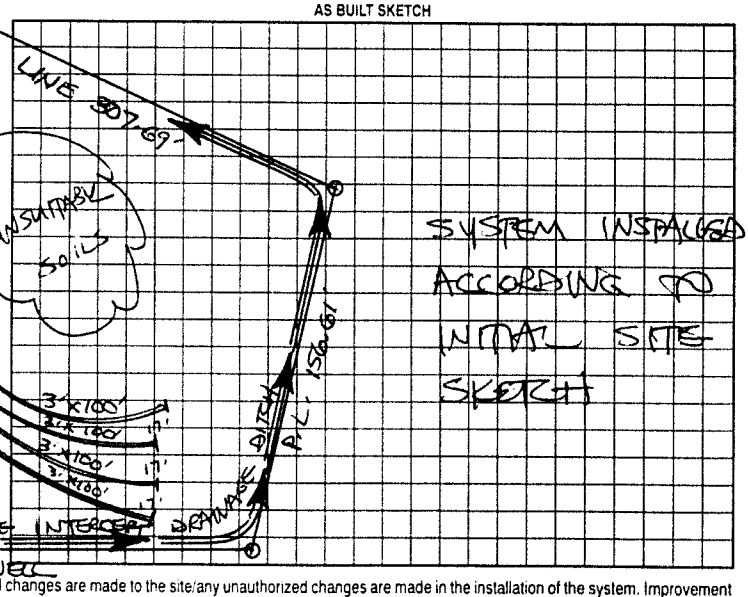

Permit can be suspended or revoked if any false information is supplied toward securing the permit/any unauthorized changes are made to the site/any unauthorized changes are made in the installation of the system. Improvement Permit with plat valid without expiration. Improvement Permit with site plan valid for sixty months. Authorization to Construct is valid for a period equal to that of Improvement Permit – not to exceed sixty months.

Signed: Allen Sayles date 5-3-01 Installed by: MARTY TUCKER

Improvement Permit by: STEVE HEDRICK date 5-2-01 Operation Permit by: STEVE HEDRICK date 6-14-01

Authorization to Construct by: STEVE HEDRICK date 5-2-01 Existing System Inspection by: ____ date ____

HEALTH DEPT COPY: WHITE OWNER COPY (FINAL): YELLOW OWNER COPY (INITIAL): PINK