IREDELL COUNTY HEALTH DEPARTMENT

STATESVILLE 704-878-5305 MOORESVILLE 704-664-5281

IMPROVEMENT PERMIT / CERTIFICATE OF COMPLETION / OPERATION PERMIT / EXISTING SYSTEM INSPECTION

PROPERTY DESCRIPTION NO. REPAIR DATE 7-14-95 TAX MAP NO. Watershed: ☐ Yes ☑ No

OWNER OR CONTRACTOR RAYMONA TEMPLETON PHONE: Business Home 539-5176

ADDRESS 242 TRIVETTE ROAD HARMONY NC 28634

LOCATION I-77 N, TR NC 901, TL EAGLE MILLS RD, TL TRIVETTE RD (1ST) 2ND HOUSE on (R)

SUBDIVISION BLOCK / SECTION LOT LOT AREA LIMITED SITE CLASS. PS DESIGN FLOW 360 L.T.A.R. EXISTING

Septic Tank: EXISTING Gallons: STB Date

Pump Tank: Gallons: PT Date

Pump Make: Model Serial No.

Nitrification Field: No Fields 1 Square Feet 450 Linear Feet 150

No Lines 2 Trench Width 36" Max Trench Bottom Depth 18-36 Gravel Depth 12"

☐ New System ☑ Repair System Type: I, II, III, IV, V, VI

System Description:

Repair System Description: CONV. GRAVITY

Maintenance Agreement Required: ☐ Yes ☑ No

☑ House/Mod. Home No. Bedrooms 3

☐ Mobile Home No. Bathrooms 1

☐ Business No. Employees

☐ Other


☐ Slab ☑ Crawl Space ☐ Basement w/plumbing ☐ Basement wo/plumbing

Water Supply: ☑ Individual ☐ Community ☐ Public

Comments: ① CHECK SEPTIC TANK FOR INTEGRITY, PUMP OUT IF NECESSARY, ② REPLACE SANITARY TEE IF NECESSARY, ③ INSTALL TWO NEW 3 LINES AS SHOWN

Comments:

INITIAL SITE SKETCH

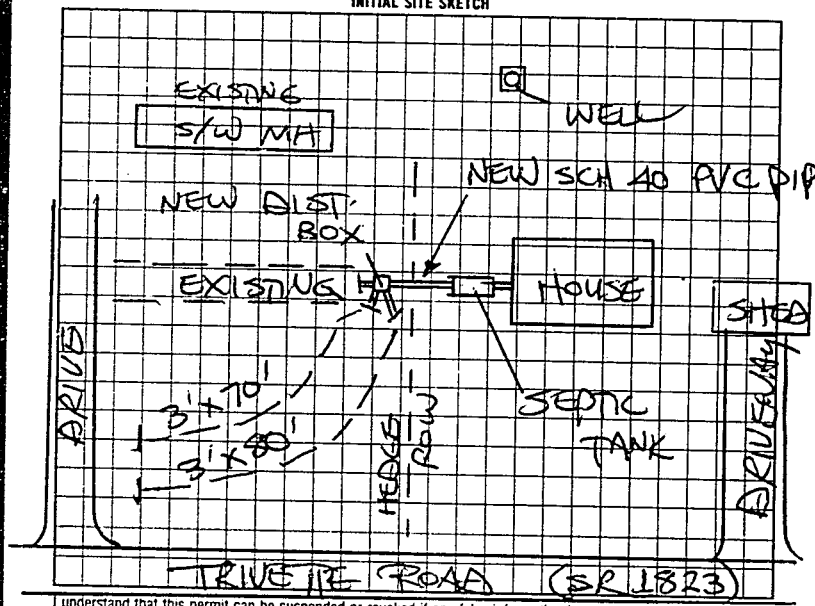

AS BUILT SKETCH

SYSTEM REPAIRED ACCORDING TO INITIAL SITE SKETCH

I understand that this permit can be suspended or revoked if any false information is supplied toward securing the permit/any unauthorized changes are made to the site/any unauthorized changes are made in the installation of the system. Improvement Permit is valid for 60 months from date of issuance.

Signed: Raymond L. Templeton

Improvement Permit by: STEVE HENDRICK date 7-14-95

Existing System Inspection by: date

Installed by: TOMMY NIXON

Certificate of Completion by: STEVE HENDRICK date 7-19-95

Operation Permit by: date

HEALTH DEPT. COPY: WHITE INSPECTION COPY (FINAL): GREEN OWNER COPY (FINAL): YELLOW INSPECTION COPY (INITIAL): PINK OWNER COPY (INITIAL): GOLD

790200