IREDELL COUNTY HEALTH DEPARTMENT

STATESVILLE 704-878-5305 MOORESVILLE 704-664-5281

IMPROVEMENT PERMIT / AUTHORIZATION TO CONSTRUCT / OPERATION PERMIT / EXISTING SYSTEM INSPECTION

PERMIT# 091705 PIN# 4863 32 7844 (PT) DATE 10-27-00

OWNER OR CONTRACTOR JOHN TRIVETTE PHONE: Business Home 539-4106

ADDRESS 537 LAKE MULLS ROAD, HARMONY, NC 28634

LOCATION I-77 N, TR NC 901, TL EAGLE MILLS RD, TL TRIVETTE RD (LS) LOT ON RIGHT ~ 1.0 MILE

SUBDIVISION BLOCK / SECTION LOT LOT AREA 1.676 ACRES SITE CLASS PS DESIGN FLOW 360 L.T.A.R. 0.40 GPD/FT²

Septic Tank: 1000 Gallons; STB 760 Date 12-11-00
Pump Tank: Gallons; PT Date
Pump Make: Model Serial No.
Nitrification Field: No Fields 1 Square Feet 900 Linear Feet 300
No Lines THREE Trench Width 36" Max Trench Bottom Depth 36" Gravel Depth 12"

✓ New System ☐ Repair System Type: ☐ II ☐ III ☐ IV ☐ V ☐ VI
System Description: CONVENTIONAL GRAVITY
Repair System Description: CONV. GRAVITY
Maintenance Agreement Required: ☐ Yes ✓ No
☐ Slab ☐ Crawl Space ☐ Basement w/plumbing ☐ Basement wo/plumbing


☐ House/Mod. Home No. Bedrooms 3
✓ Mobile Home No. Bathrooms 2
☐ Business No. Employees
☐ Other

Water Supply: ✓ Individual ☐ Public ☐ Community
WELL


Comments/Conditions:
REPAIR AREA

Comments/Conditions:
SEPTIC TANK WITH MARKER INSTALLED USING "FABEL" FILTER

INITIAL SITE SKETCH

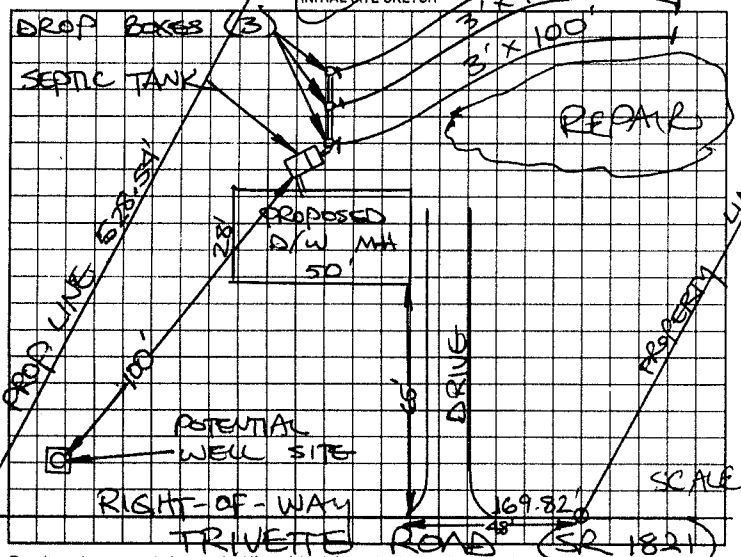

AS BUILT SKETCH

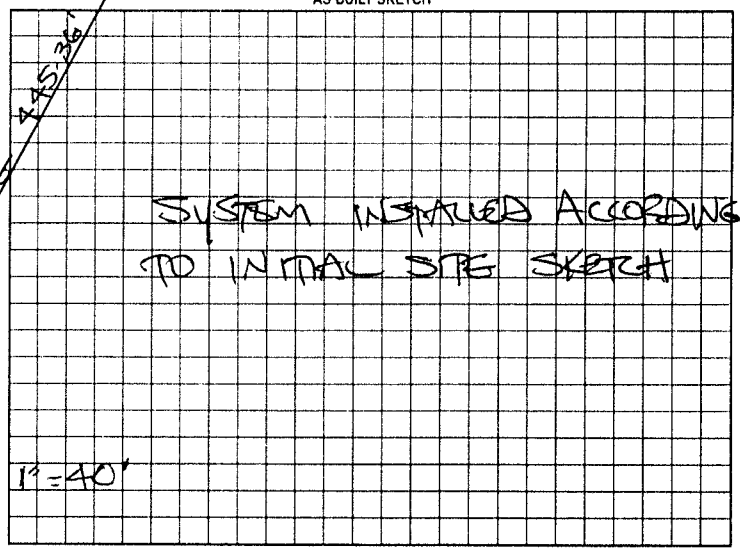

Permit can be suspended or revoked if any false information is supplied toward securing the permit/any unauthorized changes are made to the site/any unauthorized changes are made in the installation of the system. Improvement Permit with plat valid without expiration. Improvement Permit with site plan valid for sixty months. Authorization to Construct is valid for a period equal to that of Improvement Permit – not to exceed sixty months.

Signed: X [signature] date 10-27-00 Installed by: AQUA DRILL, INC

Improvement Permit by: STEVE HEDRICK date 10-27-00 Operation Permit by: STEVE HEDRICK date 4-23-01

Authorization to Construct by: STEVE HEDRICK date 10-27-00 Existing System Inspection by: date

HEALTH DEPT COPY WHITE OWNER COPY (FINAL) YELLOW OWNER COPY (INITIAL) PINK