IREDELL COUNTY HEALTH DEPARTMENT

Statesville Phone TR 3-7271 Mooresville Phone NO 3-1271

PERMIT TO INSTALL SEPTIC TANK

Permit NO. 47 Permit Date 12 - 2 19 70

Owner T. H. Wallace Address Union Grove

Installed By Sammy Parris Address Harmony N.C


Location of Property West on 901 to Williamsburg Esso Station turn right go 1½ miles turn left Grass Creek turn right, 3rd approx 1 mile on left.

Tank		Capacity		Length of Lines		Fixtures	
Block	( )	1000	( )	225'	( )	No. of Baths	( )
Precast	( )	1250	( )	250'	( )	Dishwasher	( )
		1500	( )	Other		Garbage Grdr.	( )
		Other				Other	

NOTIFY HEALTH DEPARTMENT AT LEAST EIGHT HOURS BEFORE TANK IS TO BE INSPECTED.

Final Inspection 12 - 2 19 70 Approved ( ) Disapproved ( )

Remarks

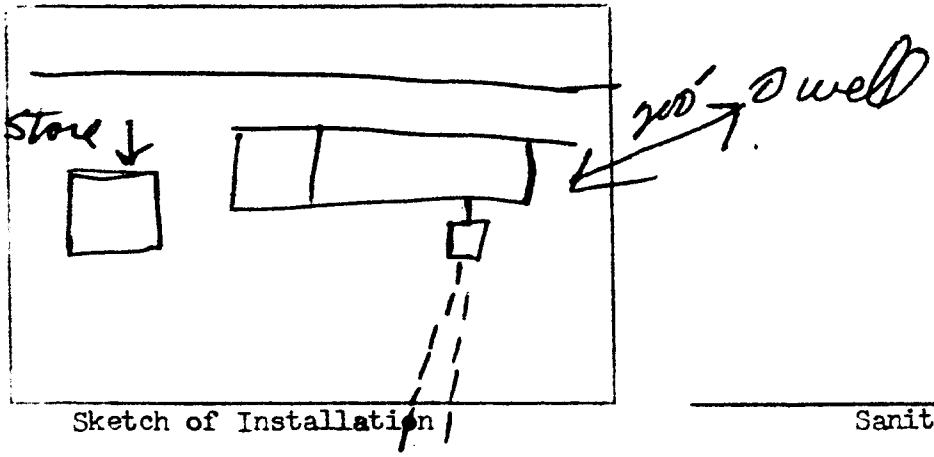

Sketch of Installation

Sanitarian