IREDELL COUNTY HEALTH DEPARTMENT

STATESVILLE 704-878-5305 MOORESVILLE 704-664-5281

IMPROVEMENT PERMIT / AUTHORIZATION TO CONSTRUCT / OPERATION PERMIT / EXISTING SYSTEM INSPECTION

PERMIT# 078000 PIN# 4863 40 1281 DATE 12-8-98

OWNER OR CONTRACTOR AMERICAN LAND PHONE Business 878-9595 Home

ADDRESS 1281 GARNER BAGNAL BLVD, STATESVILLE, NC 28677

LOCATION I-77 N, TR NC 901, TL EAGLE MILLS RD, TL TRIVETTE ROAD, LOT ON LEFT PAST CARTWRIGHT RD.

SUBDIVISION CHESHIRE RIDGE BLOCK / SECTION I LOT 19 LOT AREA 1.20 ACRES SITE CLASS PS DESIGN FLOW 360 LTAR 0.30 SQFD/PR

Septic Tank: 1000 Gallons; STB 1012 Date 9-6-99
Pump Tank: 1000 Gallons; PT 17 Date 8-17-99
Pump Make: HYDROMATIC Model SHEF50M1 Serial No
Nitrification Field: No Fields Square Feet 1200 Linear Feet 400
No Lines FIVE Trench Width 36" Max Trench Bottom Depth 36" Gravel Depth 12"

✓ New System Repair System Type (Conv.) LPP ETA
System Description CONVENTIONAL, PUMP
Repair System Description 25% REDUCTION, Pump
Maintenance Agreement Required: Yes ✓ No
Slab Crawl Space Basement w/plumbing Basement w/o plumbing

House/Mod. Home No. Bedrooms 3
Mobile Home No. Bathrooms 2
Business No. Employees
Other


Water Supply: Individual / Public / Community
WELL

Comments/Conditions: ① KEEP SYSTEM MINIMUM 100 FEET FROM WELL ② SEE ATTACHED PUMP & PRESSURE MANIFOLD REQUIREMENTS

INITIAL SITE SKETCH

Comments/Conditions: ① TANKS & LINES INSPECTED 11-29-99 ② SYSTEM FINALED 1-4-00 ③ AT TIME OF INSPECTION MH LOCATED SIX FEET FROM SIDE PROPERTY LINE & WELL INSTALLED ON NEIGHBORING LOT #18

AS BUILT SKETCH

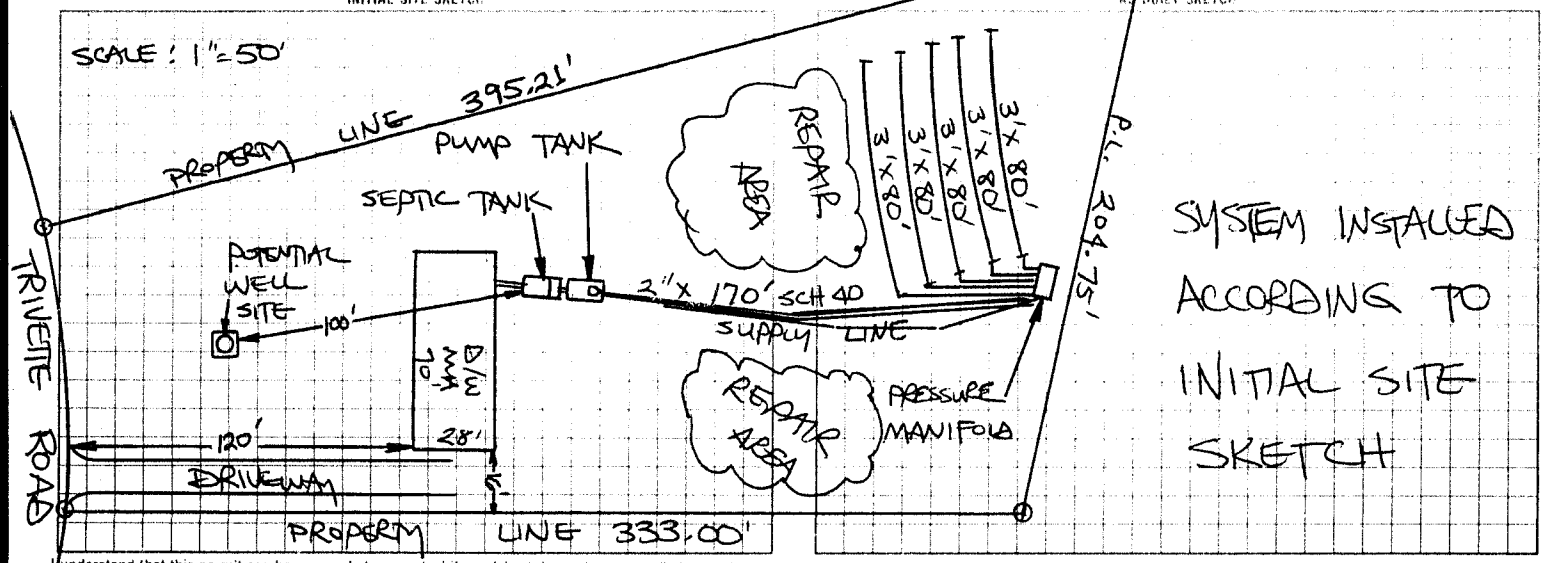

SYSTEM INSTALLED ACCORDING TO INITIAL SITE SKETCH

I understand that this permit can be suspended or revoked if any false information is supplied toward securing the permit/any unauthorized changes are made to the site/any unauthorized changes are made in the installation of the system. Improvement Permit with plat valid without expiration. Improvement Permit with site plan valid for sixty months. Authorization to Construct is valid for a period equal to that of Improvement Permit – not to exceed sixty months.

Signed: Claudette Ballard date 12-10-98

Improvement Permit by: STEVE HEDRICK date 12-8-98

Authorization to Construct by: STEVE HEDRICK date 12-8-98

Installed by: A-1 BACKHOE

Operation Permit by: STEVE HEDRICK date 1-4-00

Existing System Inspection by: date

HEALTH DEPT. COPY: WHITE INSPECTION COPY (FINAL): GREEN OWNER COPY (FINAL): YELLOW INSPECTION COPY (INITIAL): PINK OWNER COPY (INITIAL): GOLD