IREDELL COUNTY HEALTH DEPARTMENT

STATESVILLE 704-878-5305 MOORESVILLE 704-664-5281

IMPROVEMENT PERMIT / AUTHORIZATION TO CONSTRUCT / OPERATION PERMIT / EXISTING SYSTEM INSPECTION

PERMIT# 017490 PIN# 4863 40 1345 DATE 11-3-98

OWNER OR CONTRACTOR OSCAR WILSON PHONE: Business Home

ADDRESS 124 BOUNDARY LANE, HARMONY, NC 28634

LOCATION I-77 N, JR NC901, TL EAGLE MILLS, TL TRIVETTE ROAD, 7TH LOT ON LEFT PAST CARTWRIGHT ROAD

SUBDIVISION CHESHIRE RIDGE BLOCK / SECTION I LOT 20 LOT AREA 1.05 ACRES SITE CLASS PS DESIGN FLOW 360 L.T.A.R. 0.30 GPD/FT²

Septic Tank: 1000 Gallons: STB 794 Date 8-20-98
Pump Tank: Gallons: PT Date
Pump Make: Model Serial No.
Nitrification Field: No Fields 1 Square Feet EQ TO 1200 Linear Feet 300+
No Lines FOUR Trench Width 36" Max Trench Bottom Depth 36"

☑ New System ☐ Repair System Type: I, II, (III), IV, V, VI
System Description: 25% REDUCTION GRINDER
Repair System Description: 25% REDUCTION PUMP
Maintenance Agreement Required: Yes ☑ No
~~Gravel~~ Depth SAND 6"


☐ House/Mod. Home ☑ Mobile Home ☐ Business ☐ Other
No. Bedrooms 3 No. Bathrooms 2 No. Employees
☐ Slab ☑ Crawl Space ☐ Basement w/plumbing ☐ Basement wo/plumbing

Water Supply: ☑ Individual ☐ Public ☐ Community WELL


Comments:/Conditions: ① INSTALL FIFTY CHAMBERS OR THIRTY H.D.S. SECTIONS AS SHOWN
② KEEP SYSTEM MINIMUM 100' FROM WELL

Comments:/Conditions:

INITIAL SITE SKETCH

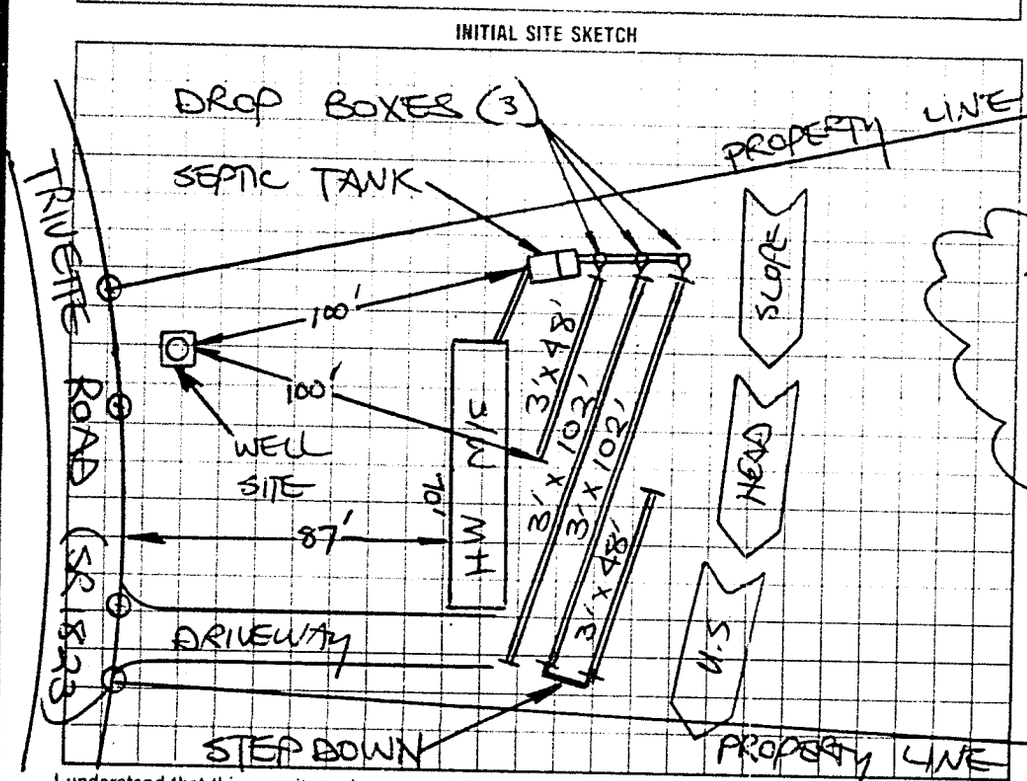

AS BUILT SKETCH

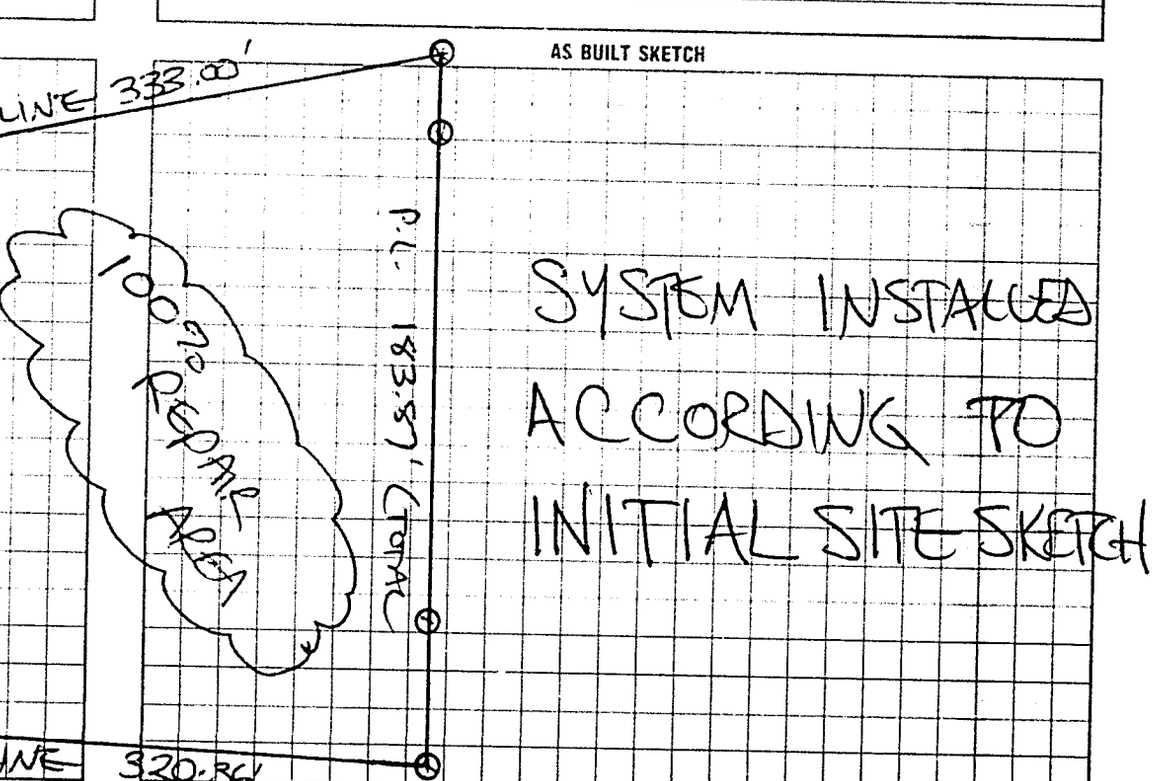

I understand that this permit can be suspended or revoked if any false information is supplied toward securing the permit/any unauthorized changes are made to the site/any unauthorized changes are made in the installation of the system. Improvement Permit with plat valid without expiration. Improvement Permit with site plan valid for sixty months. Authorization to Construct is valid for a period equal to that of Improvement Permit – not to exceed sixty months.

Signed: Claudette Ballard date 11-5-98

Improvement Permit by: STEVE HEDRICK date 11-3-98

Authorization to Construct by: STEVE HEDRICK date 11-3-98

Installed by: JAMES HUDLER

Operation Permit by: STEVE HEDRICK date 12-9-98

Existing System Inspection by: date

HEALTH DEPT. COPY: WHITE INSPECTION COPY (FINAL): GREEN OWNER COPY (FINAL): YELLOW INSPECTION COPY (INITIAL): PINK OWNER COPY (INITIAL): GOLD