IREDELL COUNTY HEALTH DEPARTMENT

STATESVILLE 704-878-5305 MOORESVILLE 704-664-5281

IMPROVEMENT PERMIT / AUTHORIZATION TO CONSTRUCT / OPERATION PERMIT / EXISTING SYSTEM INSPECTION

PERMIT# 103455 PIN# 4863-40-1345 DATE 11-27-01

OWNER OR CONTRACTOR FAUSTO C. AGUSTIN PHONE: Business Home

ADDRESS 193 TRIVETTE ROAD HARMONY, NC 28634

LOCATION I-77 N, TR NC 901, TL EAGLE MILLS RD, TL TRIVETTE RD, 7th LOT ON LEFT PAST CARTWRIGHT ROAD

SUBDIVISION CHESHIRE RIDGE BLOCK / SECTION I LOT 20 LOT AREA 1.05 ACRES SITE CLASS. PS DESIGN FLOW 360 L.T.A.R. 0.30 gpd/ft²

Septic Tank: 1000 Gallons: STB 794 Date 8-20-98
Pump Tank: ____ Gallons: PT ____ Date ____
Pump Make: ____ Model ____ Serial No. ____
Nitrification Field: No Fields 1 Square Feet EQ. TO 1200 Linear Feet 300+
No Lines FOUR Trench Width 36" Max Trench Bottom Depth 36"

☐ New System ☐ Repair System Type: I. II (III) IV. V. VI
System Description: 25% REDUCTION, GRAVITY
Repair System Description: 25% REDUCTION, Pump
Maintenance Agreement Required: ☐ Yes ☑ No

Gravel ~~Depth~~ SAND 6" ☐ Slab ☑ Crawl Space ☐ Basement w/plumbing ☐ Basement wo/plumbing


☐ House/Mod. Home No. Bedrooms 3
☑ Mobile Home No. Bathrooms 2
☐ Business No. Employees ____
☐ Other ____

Water Supply: ☑ Individual ☐ Public ☐ Community
WELL


Comments:/Conditions:

Comments /Conditions:

INITIAL SITE SKETCH

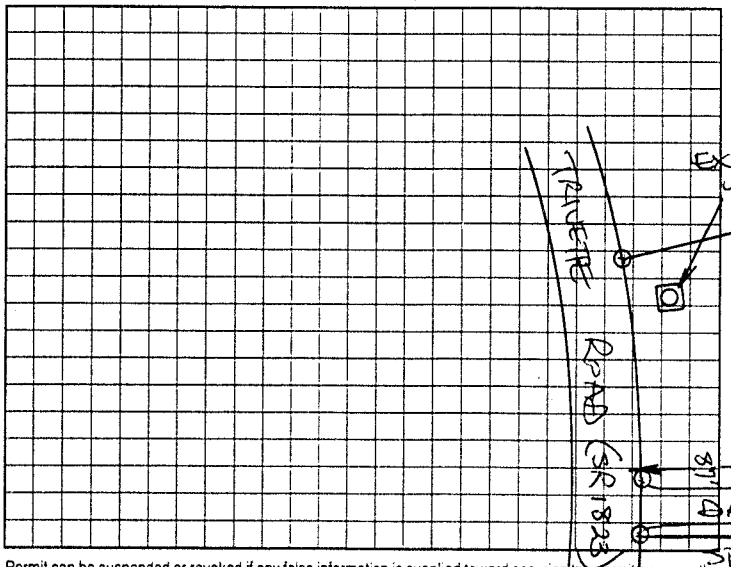

AS BUILT SKETCH

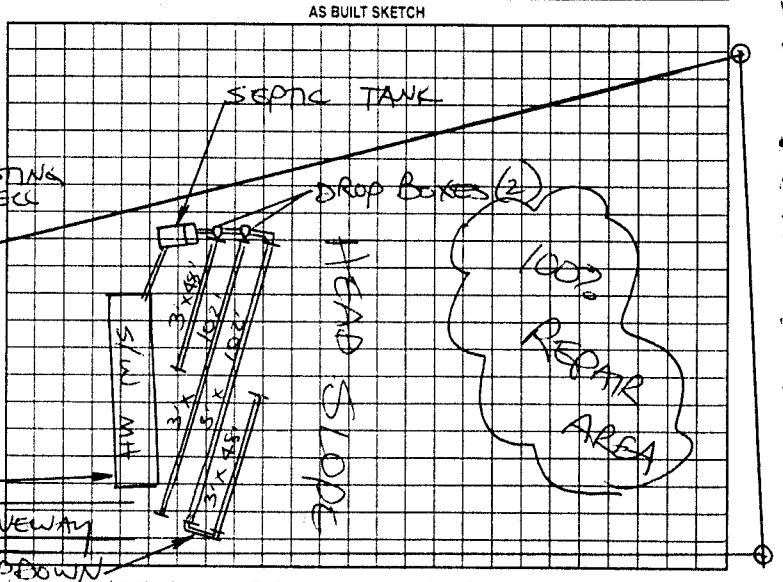

Permit can be suspended or revoked if any false information is supplied toward securing the permit, any unauthorized changes are made to the site any unauthorized changes are made in the installation of the system. Improvement Permit with plat valid without expiration. Improvement Permit with site plan valid for sixty months. Authorization to Construct is valid for a period equal to that of Improvement Permit – not to exceed sixty months.

Signed: ____ date ____

Improvement Permit by: ____ date ____

Authorization to Construct by: ____ date ____

Installed by: ____

Operation Permit by: ____ date ____

Existing System Inspection by: STEVE HENRICK date 11-27-01

HEALTH DEPT. COPY WHITE OWNER COPY (FINAL) YELLOW OWNER COPY (INITIAL) PINK