IREDELL COUNTY HEALTH DEPARTMENT

STATESVILLE 704-878-5305 MOORESVILLE 704-664-5281

IMPROVEMENT PERMIT / AUTHORIZATION TO CONSTRUCT / OPERATION PERMIT / EXISTING SYSTEM INSPECTION

PERMIT# 091113 PIN# 4863 401419 DATE 8/1/00

OWNER OR CONTRACTOR Richard Howell PHONE: Business _____ Home (704) 546-5347

ADDRESS 219 Logan Way Rd Harmony NC 28634

LOCATION 199 Trivette Rd - 77 N, L 901, L Eagle Mills, L Trivette on Lt

SUBDIVISION Cheshire Ridge BLOCK / SECTION _____ LOT 21 LOT AREA 1.05 SITE CLASS. — DESIGN FLOW 360 L.T.A.R. —

Septic Tank: Existing Gallons; STB _____ Date _____
Pump Tank: _____ Gallons; PT _____ Date _____
Pump Make: _____ Model _____ Serial No. _____
Nitrification Field: No Fields 1 Square Feet 400 Linear Feet 300'
No Lines 3 @ 100 Trench Width _____ Max Trench Bottom Depth _____ Gravel Depth _____

☐ New System ☐ Repair System Type: I, II, III, IV, V, VI
System Description: Existing 25% Red
Repair System Description: _____
Maintenance Agreement Required: ☐ Yes ☐ No
☐ Slab ☐ Crawl Space ☐ Basement w/plumbing ☐ Basement wo/plumbing


☐ House/Mod. Home No. Bedrooms 3
☒ Mobile Home No. Bathrooms 3
☐ Business No. Employees _____
☐ Other _____

Water Supply:
☒ Individual
☐ Public
☐ Community


Comments/Conditions:

Comments/Conditions

INITIAL SITE SKETCH

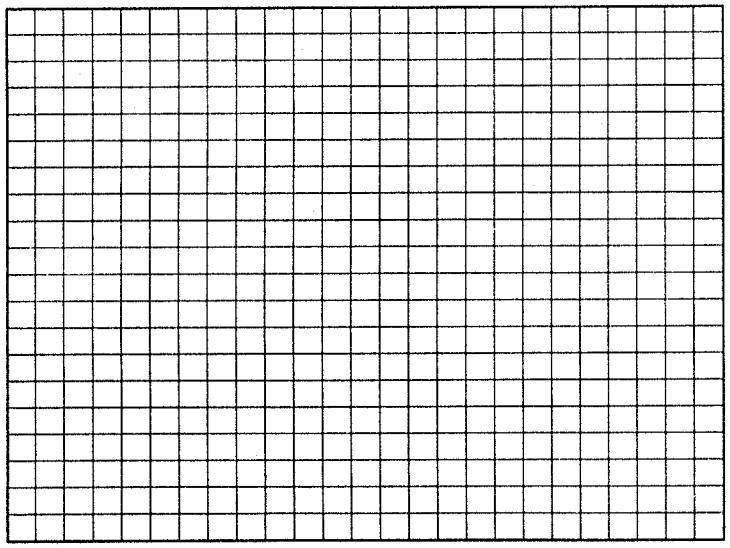

AS BUILT SKETCH

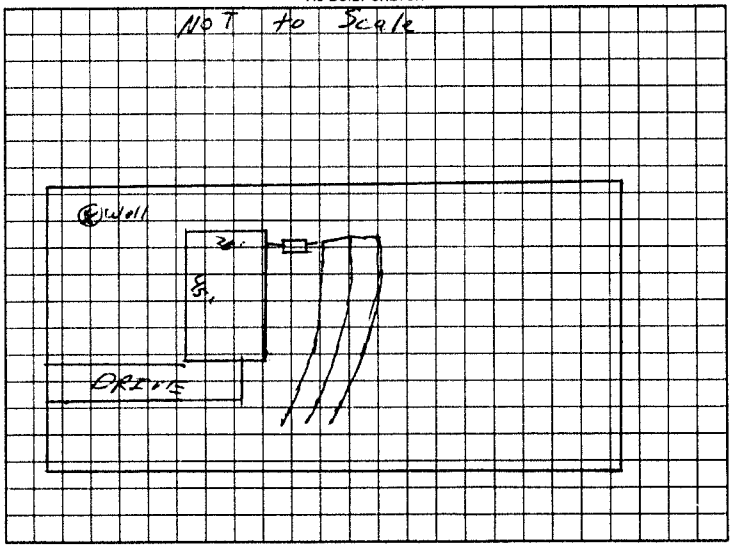

Permit can be suspended or revoked if any false information is supplied toward securing the permit/any unauthorized changes are made to the site/any unauthorized changes are made in the installation of the system. Improvement Permit with plat valid without expiration. Improvement Permit with site plan valid for sixty months. Authorization to Construct is valid for a period equal to that of Improvement Permit – not to exceed sixty months.

Signed: _____ date _____ Installed by: _____

Improvement Permit by: _____ date _____ Operation Permit by: _____ date _____

Authorization to Construct by: _____ date _____ Existing System Inspection by: [signature] RST date 8/1/00

HEALTH DEPT. COPY: WHITE OWNER COPY (FINAL): YELLOW OWNER COPY (INITIAL): PINK