1115

IREDELL COUNTY HEALTH DEPARTMENT

STATESVILLE 704-878-5305 (2nd) MOORESVILLE 704-664-5281

IMPROVEMENT PERMIT / AUTHORIZATION TO CONSTRUCT / OPERATION PERMIT / EXISTING SYSTEM INSPECTION

PERMIT # 15378 PIN # 4863-40-2038 Conales DATE 1-4-10

OWNER or APPLICANT ~~Zitlali Torres~~ Maria Jermina PHONE: Business Home: 704-546-5833

OWNER or APPLICANT ADDRESS 181 Iriuette RD Harmony

LOCATION / DIRECTIONS 901 to Eagle Mill to Iriuette on left 187 Iriuette RD

SUBDIVISION Cheshire Ridge BLOCK / SECTION LOT # 18 LOT AREA 1.13 DESIGN FLOW 480 L.T.A.R. .3 Exist

Septic Tank 1000 Gallons: STB 1012 Date 4-24-00

Pump Tank 1000 Gallons: P T 17 Date 12-14-99

Pump Make Hudson Model SHEF 50 A1 Serial # S1867-004

Nitrification Field No Fields 1 No Lines 4 Linear Feet 400

Trench Width 36" Max. Trench Bottom Depth 36" Gravel Depth NA

☐ New System ☐ Repair ☐ Expansion System Type I II III IV V VI

System Description: 2570 Gravity

Repair System Description: 3070 Low Pr

Maintenance Agreement Required ☐ YES ☒ NO

☐ GRAVITY ☒ PRESSURE

☑ Residence No. Bedrooms 4

☐ Business No. Persons

☐ Other No. Employees

☐ Slab ☐ Crawl Space

☐ Basement w/plumbing ☐ Basement w/o plumbing


Water Supply: ☑ Private ☐ Public ☐ Community

Comments / Conditions


Comments / Conditions

* Deed, Pump Control Electrical Circuit map and High water alarm

INITIAL SITE SKETCH

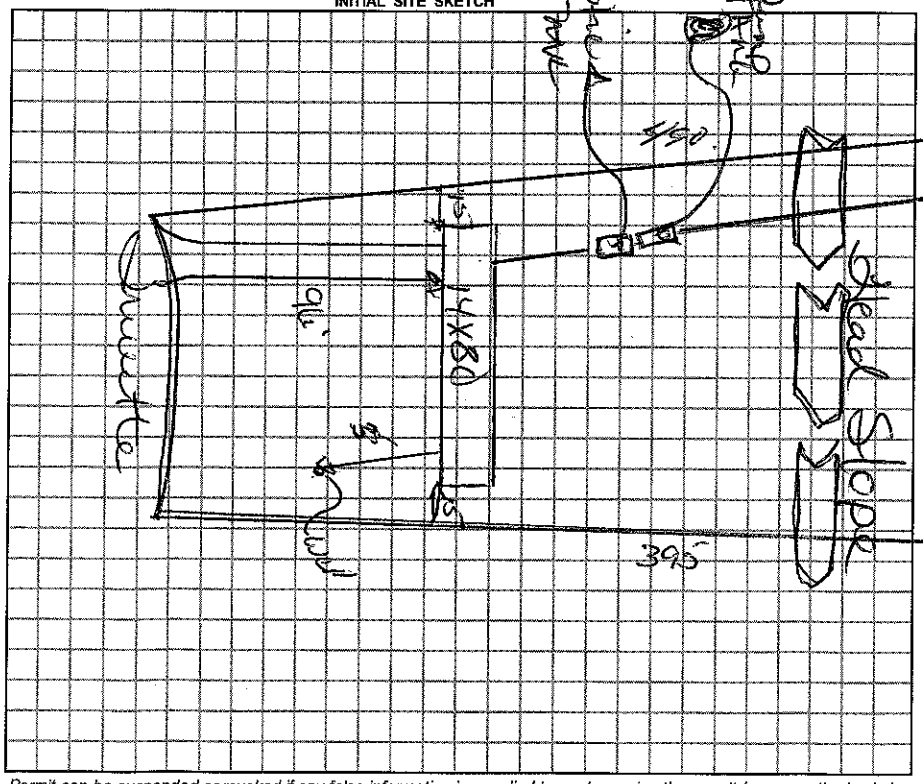

AS BUILT SKETCH

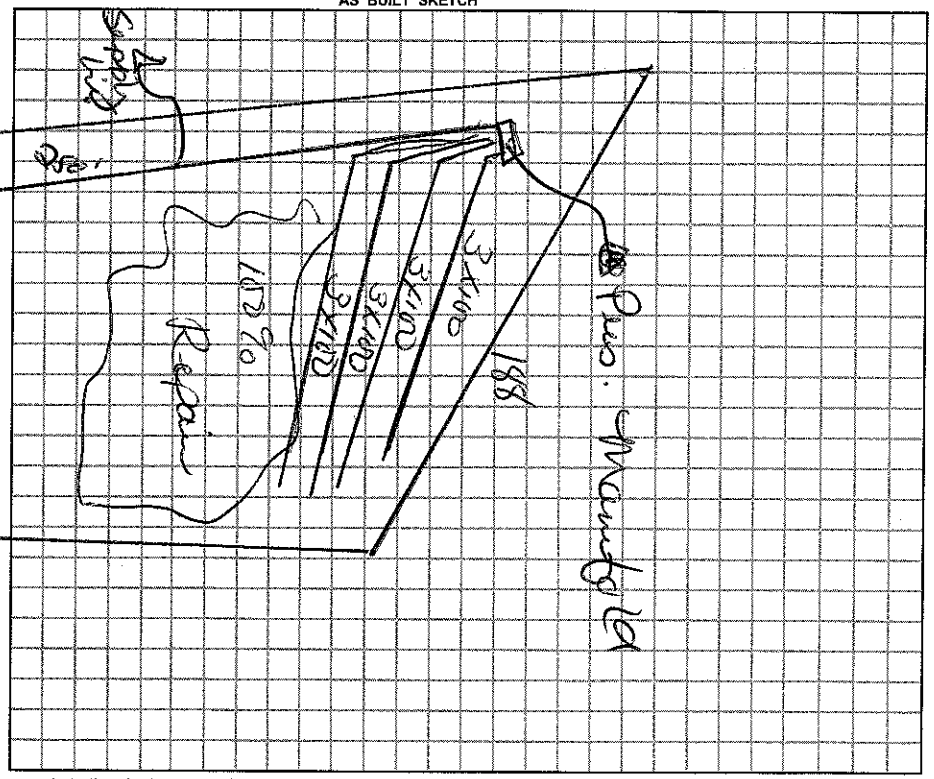

Permit can be suspended or revoked if any false information is supplied toward securing the permit / any unauthorized changes are made to the site / any unauthorized changes are made in the installation of the system.

☐ *IMPROVEMENT PERMIT w / plat valid without expiration.* ☐ *IMPROVEMENT PERMIT w / site plan valid for 60 mos.* ☑ *AUTHORIZATION TO CONSTRUCT valid for period equal to IMPROVEMENT PERMIT-not to exceed 60 mo.*

Owner / Applicant Signature: Zitlali Torres Date 1-6-10

Improvement Permit by: Date 1-4-10

Authorization to Construct by: Date 1-4-10

YOU SHOULD CONTACT A LOCATOR SERVICE PRIOR TO ANY EXCAVATION.

Installed by:

Operation Permit by: Date: 3-17-10

Existing System Inspected by: Date:

WHITE COPY Environmental Health YELLOW COPY (Final) Owner / Applicant PINK COPY (Initial) Owner / Applicant