IREDELL COUNTY HEALTH DEPARTMENT

STATESVILLE 704-878-5305 MOORESVILLE 704-664-5281

IMPROVEMENT PERMIT / AUTHORIZATION TO CONSTRUCT / OPERATION PERMIT / EXISTING SYSTEM INSPECTION

PERMIT# 090134 PIN# 4863 40 2038 DATE 6-30-00

OWNER OR CONTRACTOR RONNIE GIVENS PHONE: Business 872-2726 Home 878-2517

ADDRESS 117 CLOVERWOOD LANE, TROUTMAN, NC 28166

LOCATION I-77 N, TR NC 901, TL CRATER RD, TR CARTWRIGHT RD, TL TRIVETTE RD, 5TH LOT ON LEFT

SUBDIVISION CHESTNUT RIDGE BLOCK / SECTION I LOT 18 LOT AREA 1.31 ACRES SITE CLASS PS DESIGN FLOW 480 L.T.A.R. 0.30 GPD/FT²

Septic Tank: 1000 Gallons; STB 1012 Date 4-24-00
Pump Tank: 1000 Gallons; PT 17 Date 12-14-99
Pump Make: HYDROMATIC Model 3SE50A1 Serial No. 5187-0087
Nitrification Field: No Fields 1 Square Feet Eq. to 1600 Linear Feet 400± No Lines FOUR Trench Width 36" Max Trench Bottom Depth 24" Gravel Depth 6" SAND

☑ New System ☐ Repair System Type: I, II, (III), IV, V, VI
System Description: 25% REDUCTION, PUMP
Repair System Description: 50% REDUCTION, PUMP
Maintenance Agreement Required: ☐ Yes ☑ No


☐ House/Mod. Home No. Bedrooms 4
☑ Mobile Home No. Bathrooms 2
☐ Business No. Employees
☐ Other
☐ Slab ☑ Crawl Space ☐ Basement w/plumbing ☐ Basement wo/plumbing

Water Supply: ☑ Individual ☐ Public ☐ Community WELL


Comments/Conditions: ① KEEP SYSTEM MINIMUM 100 FEET FROM WELL (.1956 (6)(b)) ② INSTALL 25% REDUCTION SYSTEM USING SIXTY-SEVEN (67) CHAMBERS OR 40 HDS SECTIONS ③ SEE ATTACHED SHEETS FOR PUMP AND PRESSURE MANIFOLD REQUIREMENTS.

Comments/Conditions: LINES, TANKS, & PUMP INSPECTED AND PRESSURE CHECKED 7-5-2000 - RSH

INITIAL SITE SKETCH

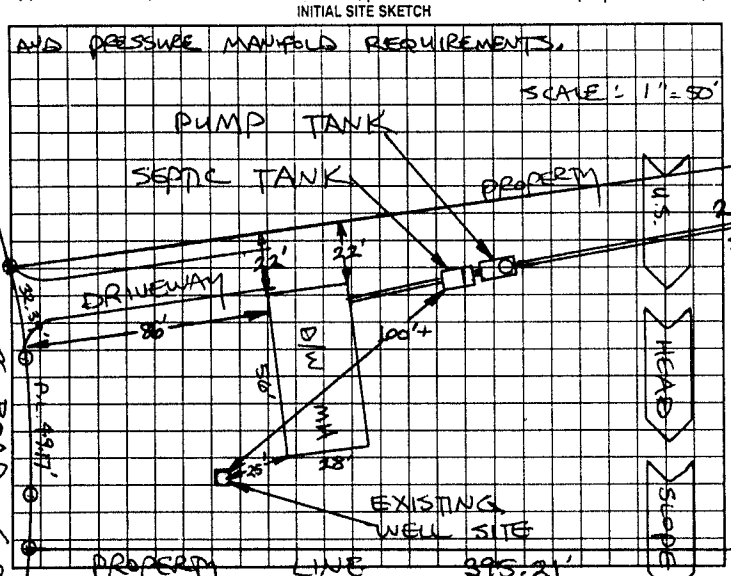

AS BUILT SKETCH

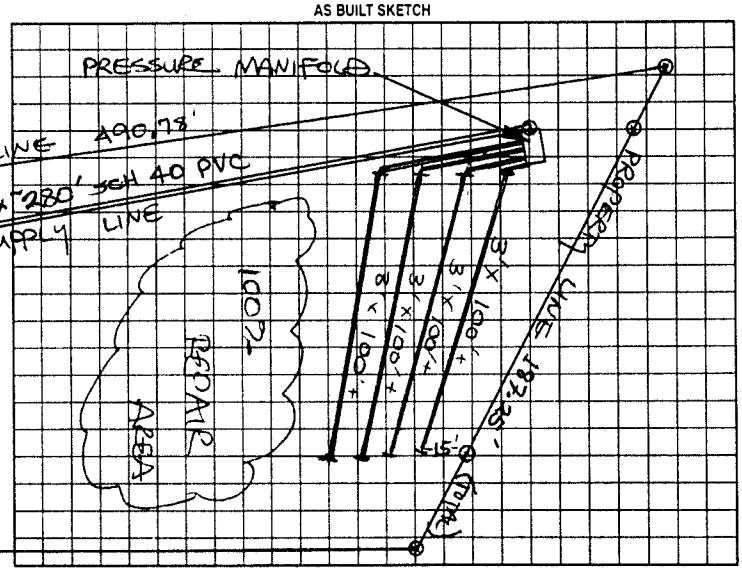

Permit can be suspended or revoked if any false information is supplied toward securing the permit/any unauthorized changes are made to the site/any unauthorized changes are made in the installation of the system. Improvement Permit with plat valid without expiration. Improvement Permit with site plan valid for sixty months. Authorization to Construct is valid for a period equal to that of Improvement Permit – not to exceed sixty months.

Signed: Ronnie Givens date 7-3-00 Installed by: A-1 BACKHOE

Improvement Permit by: STEVE HEDRICK date 6-30-00 Operation Permit by: STEVE HEDRICK date 9-7-00

Authorization to Construct by: STEVE HEDRICK date 6-30-00 Existing System Inspection by: date

HEALTH DEPT. COPY: WHITE OWNER COPY (FINAL): YELLOW OWNER COPY (INITIAL): PINK

TRIVETTE ROAD (SR 1821)