IREDELL COUNTY HEALTH DEPARTMENT

STATESVILLE 704-878-5305 MOORESVILLE 704-664-5281

IMPROVEMENT PERMIT / AUTHORIZATION TO CONSTRUCT / OPERATION PERMIT / EXISTING SYSTEM INSPECTION

PERMIT# 81085 PIN# 4863409152 DATE 5-17-99

OWNER OR CONTRACTOR Jacinto Miguel PHONE: Business [redacted] Home 539 4622

ADDRESS 374 Howard Bridge Rd Union Grove N.C.

LOCATION 901 E To Eagle Mill To Trivette TR Whispering Dr. 1st lot L/L

SUBDIVISION Cheshire Ridge BLOCK / SECTION III LOT 33 LOT AREA 1.05acres SITE CLASS PSD DESIGN FLOW 360 L.T.A.R. .3

Septic Tank: 1000 Gallons; STB 1017 Date 4-25-99
Pump Tank: Gallons; PT Date
Pump Make: Model Serial No.
Nitrification Field: No Fields 1 Square Feet 900 Linear Feet 300
No Lines 3 Trench Width 36" Max Trench Bottom Depth 36" Gravel Depth N/A

☒ New System ☐ Repair System Type: I. II. III IV. V. VI
System Description: Gravity ~~Conv.~~ 25%Red.
Repair System Description:
Maintenance Agreement Required: ☐ Yes ☒ No

☐ House/Mod. Home ☒ Mobile Home ☐ Business ☐ Other
No. Bedrooms 3 No. Bathrooms 2 No. Employees


☐ Slab ☒ Crawl Space ☐ Basement w/plumbing ☐ Basement wo/plumbing

Water Supply: ☒ Individual ☐ Public ☐ Community

Comments/Conditions:

Comments/Conditions:

INITIAL SITE SKETCH

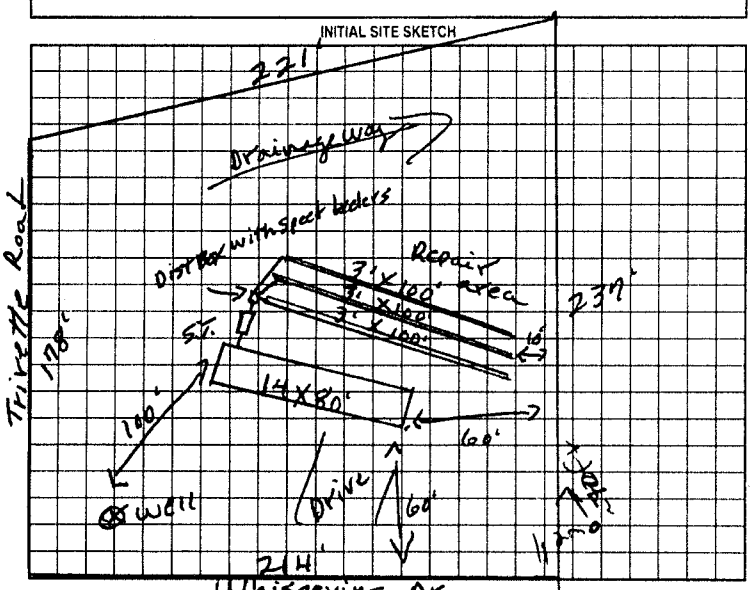

AS BUILT SKETCH

Installed as shown

Permit can be suspended or revoked if any false information is supplied toward securing the permit/any unauthorized changes are made to the site/any unauthorized changes are made in the installation of the system. Improvement Permit with plan valid without expiration. Improvement Permit with site plan valid for sixty months. Authorization to Construct is valid for a period equal to that of Improvement Permit – not to exceed sixty months.

Signed: [signature] date 5-18-99 Installed by: A-1 Backhoe

Improvement Permit by: F. C. Moore date 5-17-99 Operation Permit by: [signature] date 6-10-99

Authorization to Construct by: F. C. Moore date 5-17-99 Existing System Inspection by: date

HEALTH DEPT COPY WHITE OWNER COPY (FINAL) YELLOW OWNER COPY (INITIAL) PINK