pd $125 ur

IREDELL COUNTY HEALTH DEPARTMENT

STATESVILLE 704-878-5305 MOORESVILLE 704-664-5281

IMPROVEMENT PERMIT / AUTHORIZATION TO CONSTRUCT / OPERATION PERMIT / EXISTING SYSTEM INSPECTION

PERMIT# 101894 PIN# 4863-41-3605 DATE 8-20-01

OWNER OR CONTRACTOR MICHAEL P. BARNETTE PHONE: Business Home (704) 539-4583

ADDRESS 145 CORNWALL ROAD, HARMONY, NC 28634

LOCATION I-77 N, TR NC 901, TL EAGLE MILLS RD, TL TRIVETTE RD, TR CORNWALL RD, 2ND DWELLING ON LEFT

SUBDIVISION KNABER BLOCK / SECTION LOT 6 LOT AREA 1.16 ACRES SITE CLASS PS DESIGN FLOW 480 L.T.A.R. 0.25 GPD/FT²

Septic Tank: EXISTING Gallons: STB Date

Pump Tank: Gallons: PT Date

Pump Make: Model Serial No.

Nitrification Field: No Fields 1 Square Feet 1380 Linear Feet 460

No Lines THREE Trench Width 36" Max Trench Bottom Depth 36' Gravel Depth 12"

☑ New System ☐ Repair System Type: I (II) III IV V VI

System Description: CONVENTIONAL GRAVITY

Repair System Description: CONV. GRAVITY

Maintenance Agreement Required: ☐ Yes ☑ No

☐ House/Mod. Home ☑ Mobile Home ☐ Business ☐ Other

No. Bedrooms 4 No. Bathrooms 2 No. Employees


☐ Slab ☑ Crawl Space ☐ Basement w/plumbing ☐ Basement wo/plumbing

Water Supply: ☑ Individual ☐ Public ☐ Community WELL

Comments/Conditions: KEEP SYSTEM MINIMUM 5' FROM BUILDING FOUNDATION

Comments/Conditions:

INITIAL SITE SKETCH

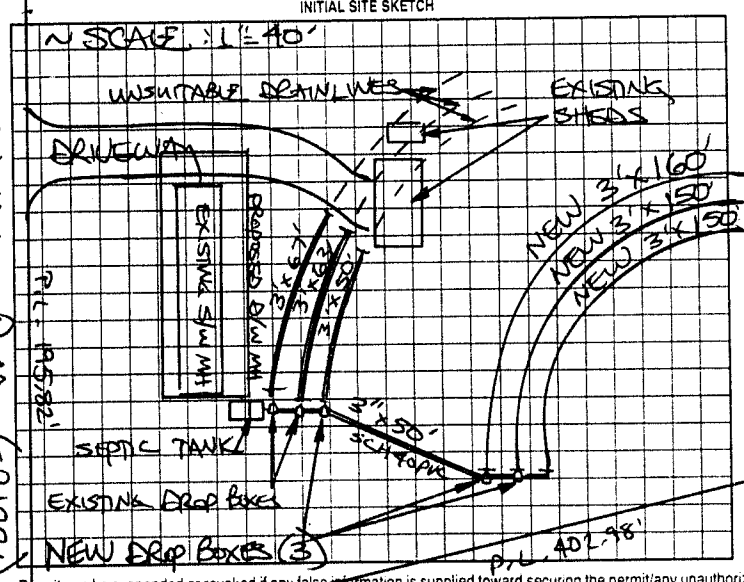

AS BUILT SKETCH

SYSTEM EXPANDED ACCORDING TO INITAL SITE SKETCH

Permit can be suspended or revoked if any false information is supplied toward securing the permit/any unauthorized changes are made to the site/any unauthorized changes are made in the installation of the system. Improvement Permit with plat valid without expiration. Improvement Permit with site plan valid for sixty months. Authorization to Construct is valid for a period equal to that of Improvement Permit – not to exceed sixty months.

Signed: Athena M Barnette date 8-20-01 Installed by: CRAIG THOMPSON

Improvement Permit by: STEVE HEDRICK date 8-20-01 Operation Permit by: STEVE HEDRICK date 9-11-01

Authorization to Construct by: STEVE HEDRICK date 8-20-01 Existing System Inspection by: date

HEALTH DEPT COPY WHITE OWNER COPY (FINAL) YELLOW OWNER COPY (INITIAL) PINK