TUES

IREDELL COUNTY HEALTH DEPARTMENT

STATESVILLE 704-878-5305 MOORESVILLE 704-664-5281

IMPROVEMENT PERMIT / AUTHORIZATION TO CONSTRUCT / OPERATION PERMIT / EXISTING SYSTEM INSPECTION

PERMIT # REPAIR PIN # 4863424209 DATE 6-25-09

OWNER or APPLICANT CRAIG KEIGER PHONE: Business 704-546-3550 Home: 704-682-3743

OWNER or APPLICANT ADDRESS 177 CORNWALL RD Harmony NC 28634

LOCATION / DIRECTIONS 77 N (R) 901 (L) Winthrop (L) Crater (R) Cartwright (L) Trivette (R) Cornwall 8th LOT ON LEFT AT BOX # 177

SUBDIVISION ROBERT C KEIGER BLOCK / SECTION LOT # 2 LOT AREA 1.892 DESIGN FLOW 480 L.T.A.R. .3


Septic Tank	1000	Gallons: STB	821	Date	9-9-95	☑ New System	☒ Repair	☐ Expansion System	Type I II III IV V VI
Pump Tank		Gallons: PT		Date		System Description:	Gravity 25% REDUCTION		
Pump Make		Model		Serial #		Repair System Description:			
Nitrification Field	No Fields 1	No Lines 4	Linear Feet 400'			Maintenance Agreement Required	☐ YES	☒ NO	
Trench Width	36"	Max. Trench Bottom Depth	36"	Gravel Depth	N/A	☒ GRAVITY	☐ PRESSURE		

☒ Residence	No. Bedrooms	4	Water Supply		
☐ Business	No. Persons	5	☒ Private		
☐ Other	No. Employees		☐ Public		
☐ Slab	☒ Crawl Space		☐ Community		
☐ Basement w/plumbing	☐ Basement w/o plumbing				

Comments / Conditions (1) Install BULL RUN VALVE # 4 NEW LINES 100' LONG AS DRAWN (2) OLD SYSTEM HAS Grease Build Up in thats why BULL RUN VALVE IS 2 BE INSTALLED. (3) Owner marked

Comments / Conditions PIL'S: (4) This permit serves AS Notice of Violation + must be repaired within 30 DAYS. (5) PUMP TANK + DROP BOXES IN ORDER TO REMOVE Grease in lines + tank.

INITIAL SITE SKETCH

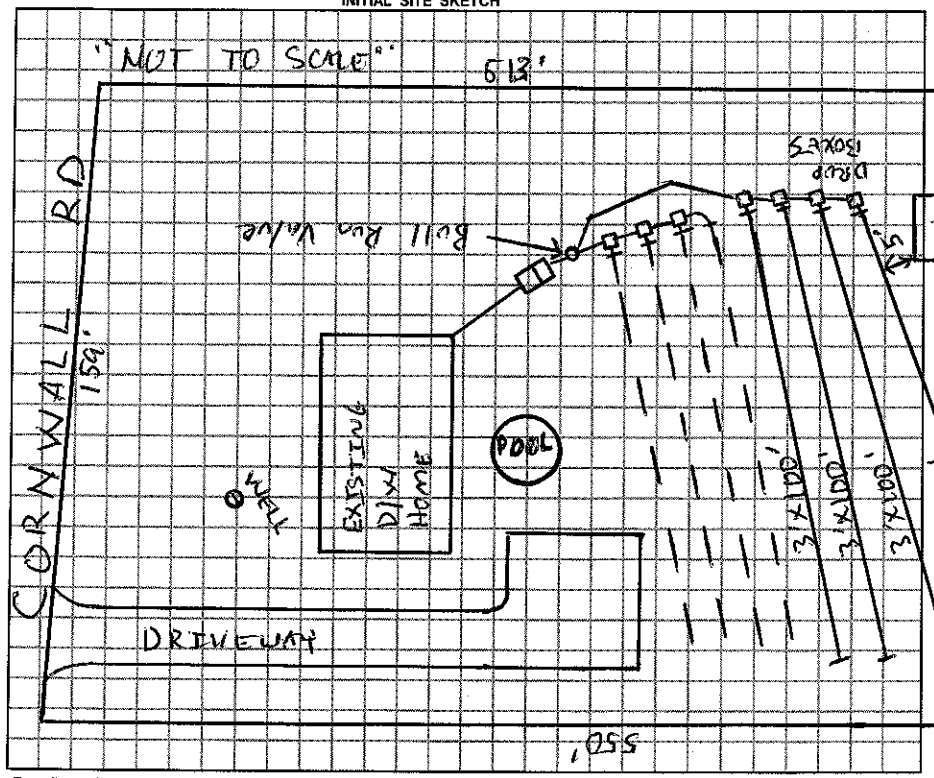

AS BUILT SKETCH

#1 New System
#2 Old System
VALVE #5
OWNER NOTIFIED OF H2O LEAK

Permit can be suspended or revoked if any false information is supplied toward securing the permit / any unauthorized changes are made to the site / any unauthorized changes are made in the installation of the system.

☐ *IMPROVEMENT PERMIT w / plat valid without expiration* ☐ *IMPROVEMENT PERMIT w / site plan valid for 60 mos.* ☐ *AUTHORIZATION TO CONSTRUCT valid for period equal to IMPROVEMENT PERMIT-not to exceed 60 mo.*

Owner / Applicant Signature: Craig Keiger Date 6/25/09

Improvement Permit by: RS Date 6/25/09

Authorization to Construct by: RS Date 6/25/09

Installed by: Piedmont Backhoe

Operation Permit by: Date: 6/26/09

Existing System Inspected by: Date:

YOU SHOULD CONTACT A LOCATOR SERVICE PRIOR TO ANY EXCAVATION.

WHITE COPY Environmental Health YELLOW COPY (Final) Owner / Applicant PINK COPY (Initial) Owner / Applicant