THIS PERMIT VOIDS PREVIOUS ISSUED 7-27-95/56856

IREDELL COUNTY HEALTH DEPARTMENT

STATESVILLE 704-878-5305 MOORESVILLE 704-664-5281

IMPROVEMENT PERMIT / CERTIFICATE OF COMPLETION / OPERATION PERMIT / EXISTING SYSTEM INSPECTION

PROPERTY DESCRIPTION NO. 2172 DATE 8-21-95 TAX MAP NO. 16J-1-A-2 Watershed: ☐ Yes ☑ No

OWNER OR CONTRACTOR CRAIG KEIGER PHONE: Business Home 878-2231

ADDRESS 1636 BELFAST ROAD STVL NC 28677

LOCATION I-77 N TO NC 901, TL WINTHROP, TL CRATER, TR CARTWRIGHT, TL TRIVETTE, TR CORNWALL, 8TH

SUBDIVISION Rose Crest Manor BLOCK / SECTION LOT 2 LOT AREA 1.892 AC SITE CLASS. PS DESIGN FLOW 480 L.T.A.R. 0.35 GPD/FT²

Septic Tank: 1000 Gallons; STB 821 Date 8-9-95

Pump Tank: Gallons; PT Date

Pump Make: Model Serial No.

Nitrification Field: No Fields 1 Square Feet 1380 Linear Feet 460

No Lines 4 Trench Width 36" Max Trench Bottom Depth 18-36" Gravel Depth 12"

☑ New System ☐ Repair System Type: I II III IV V VI

System Description: CONVENTIONAL GRAVITY

Repair System Description: CONV. GRAVITY

Maintenance Agreement Required: ☐ Yes ☑ No

☐ House/Mod. Home ☑ Mobile Home ☐ Business ☐ Other

No. Bedrooms 4 No. Bathrooms 2 No. Employees


☐ Slab ☑ Crawl Space ☐ Basement w/plumbing ☐ Basement wo/plumbing

Water Supply: ☑ Individual ☐ Community ☐ Public WELL

Comments: ① KEEP SYSTEM MINIMUM 15' FROM POOL 100' FROM WELL ② INSTALL LINES ON CONTOUR, NO DEEPER THAN 36", 9' O.C.

Comments:

INITIAL SITE SKETCH

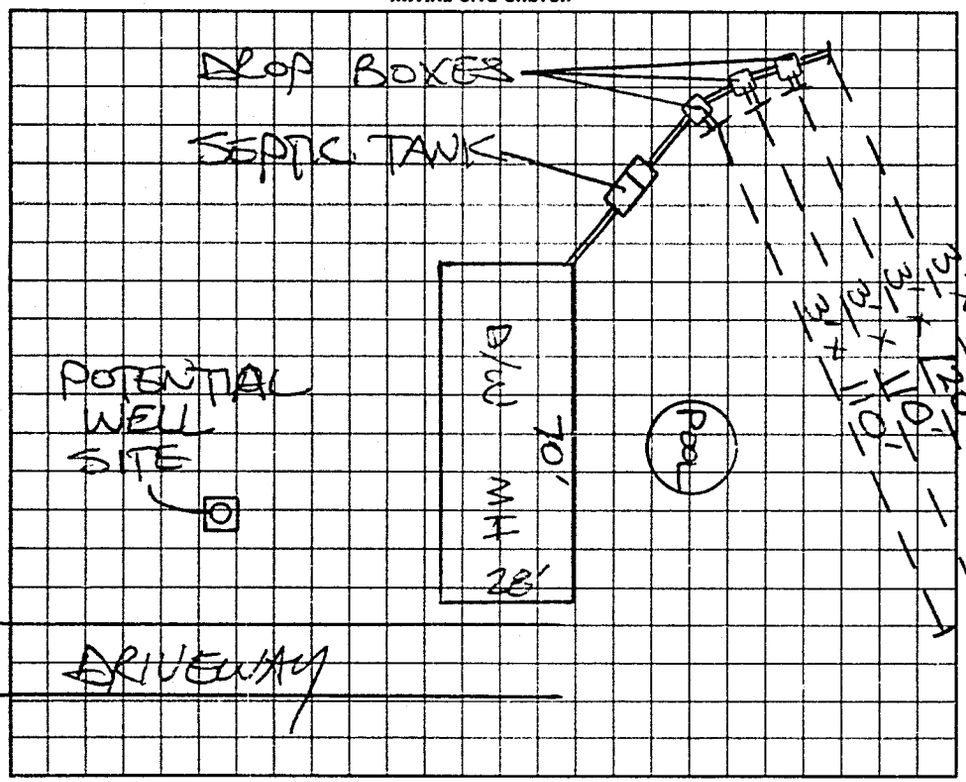

AS BUILT SKETCH

SYSTEM INSTALLED ACCORDING TO INITIAL SITE SKETCH

I understand that this permit can be suspended or revoked if any false information is supplied toward securing the permit/any unauthorized changes are made to the site/any unauthorized changes are made in the installation of the system.

Signed: Jerrod Keiger

Improvement Permit by: STEVE HEDRICK date 8/21/95

Existing System Inspection by: date

Installed by: GARY MILLER

Certificate of Completion by: STEVE HEDRICK date 9-12-95

Operation Permit by: date

HEALTH DEPT. COPY: WHITE INSPECTION COPY (FINAL): GREEN OWNER COPY (FINAL): YELLOW INSPECTION COPY (INITIAL): PINK OWNER COPY (INITIAL): GOLD