IREDELL COUNTY HEALTH DEPARTMENT

STATESVILLE 704-878-5305 (CT) MOORESVILLE 704-664-5281

IMPROVEMENT PERMIT / AUTHORIZATION TO CONSTRUCT / OPERATION PERMIT / EXISTING SYSTEM INSPECTION

PERMIT# 136916 PIN# 4863465255 1234 DATE 7-28-06

OWNER OR APPLICANT Karl Jenkins PHONE: Business _____ Home 704 622 0000

ADDRESS 526 Trivette Rd

LOCATION Hwy 901, right on Mollis, Left on Trivette Rd, across Rd from 527

SUBDIVISION n/a BLOCK / SECTION n/a LOT n/a LOT AREA 33.494 SITE CLASS. PS DESIGN FLOW 240 L.T.A.R. .3

Septic Tank: 1000 Gallons; STB 1012 Date 3-7-06
Pump Tank: _____ Gallons; PT _____ Date _____
Pump Make: _____ Model _____ Serial No. _____
Nitrification Field: No Fields 1 Square Feet 800 Linear Feet 200
No Lines 3 Trench Width 36" Max Trench Bottom Depth 36"

☒ New System ☐ Repair ☐ Expansion System Type: I (II) III IV V VI
System Description: 25% Reduction - Gravity
Repair System Description: 25% Reduction -
Maintenance Agreement Required: ☐ Yes ☒ No

☒ House/Mod. Home No. Bedrooms 2
☐ Mobile Home No. Persons ____
☐ Business No. Employees ____
☐ Other _____


Water Supply: ☒ Individual ☒ Public ☐ Community

Gravel Depth n/a ☒ Gravity ☐ Pressure ☐ Slab ☒ Crawl Space ☐ Basement w/plumbing ☐ Basement wo/plumbing


Comments:/Conditions:

Comments:/Conditions:
Yellow filter
S/T marker
no risers

INITIAL SITE SKETCH

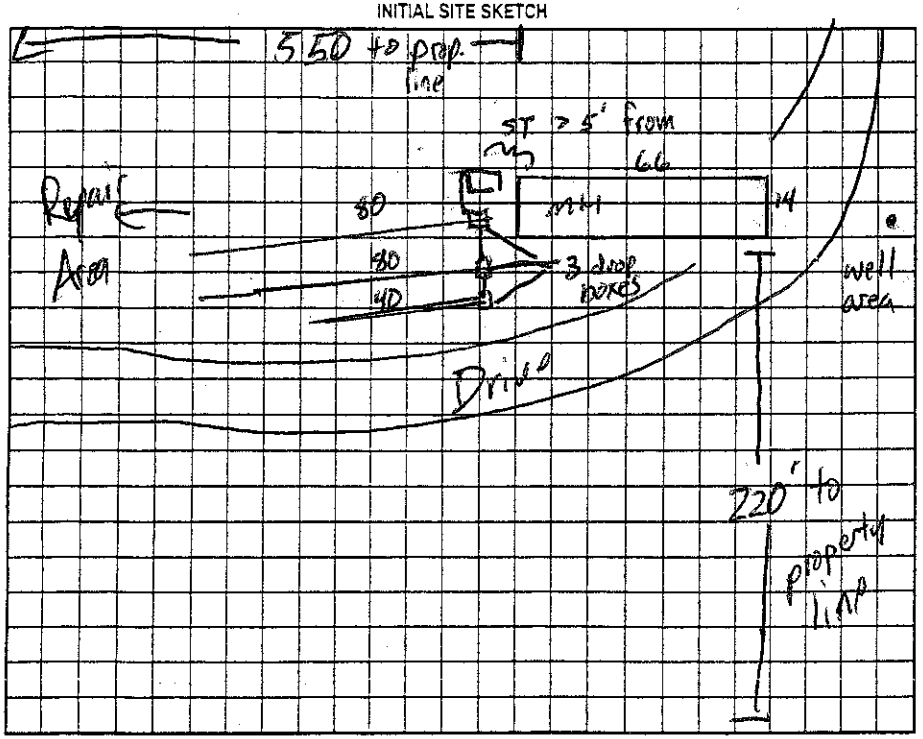

AS BUILT SKETCH

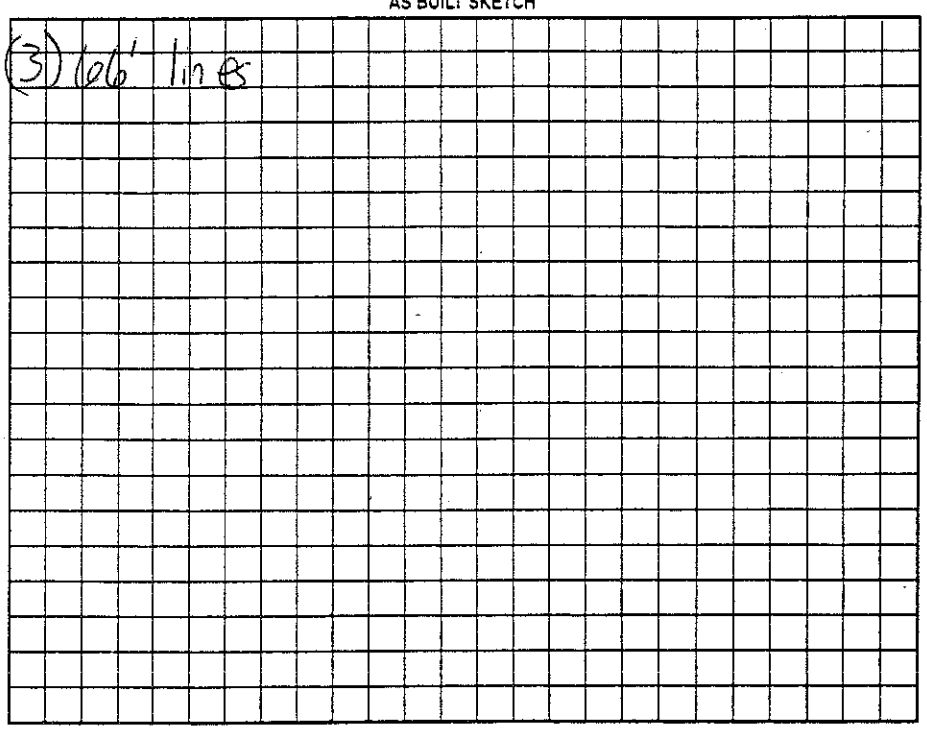

Permit can be suspended or revoked if any false information is supplied toward securing the permit/any unauthorized changes are made to the site/any unauthorized changes are made in the installation of the system. Improvement Permit with plat valid without expiration ☐ Improvement Permit with site plan valid for sixty months ☐ Authorization to Construct is valid for a period equal to that of Improvement Permit – not to exceed sixty months.

Signed: _____ date 7-31-06 Installed by: A-1 Backhoe

Improvement Permit by: _____ date 7-28-06 Operation Permit by: _____ date 9/21/06

Authorization to Construct by: _____ date 7-28-06 Existing System Inspection by: _____ date _____

HEALTH DEPT. COPY: WHITE OWNER COPY (FINAL): YELLOW OWNER COPY (INITIAL): PINK