IREDELL COUNTY HEALTH DEPARTMENT

STATESVILLE 704-878-5305 MOORESVILLE 704-664-5281

IMPROVEMENT PERMIT / AUTHORIZATION TO CONSTRUCT / OPERATION PERMIT / EXISTING SYSTEM INSPECTION

PERMIT# 078004 PIN# 4863 50 2713 (PART) DATE 12-8-98

OWNER OR CONTRACTOR AMERICAN LAND PHONE: Business 878-9595 Home

ADDRESS 1281 GARNER BAGNAL BLVD, STATESVILLE NC 28677

LOCATION I-77 N, TR NC 901, TL EAGLE MILLS, TL TRIVETTE, TR WHISPERING DRIVE, LOT ON LEFT

SUBDIVISION CHESHIRE RIDGE BLOCK / SECTION III LOT 29 LOT AREA 1.00 ACRE SITE CLASS PS DESIGN FLOW 360 L.T.A.R. 0.30 GPD/FT²

Septic Tank: 1000 Gallons; STB 1012 Date 12-28-98

Pump Tank: Gallons; PT Date

Pump Make: Model Serial No

Nitrification Field: No Fields 1 Square Feet 1200 Linear Feet 400

No Lines FOUR Trench Width 36" Max Trench Bottom Depth 30" Gravel Depth 12"

✓ New System Repair System Type I (II) III IV V VI

System Description: CONVENTIONAL GRAVITY

Repair System Description: CONV. GRAVITY

Maintenance Agreement Required Yes ✓ No

Slab Crawl Space Basement w/plumbing Basement w/o plumbing

House/Mod Home No Bedrooms 3

Mobile Home No Bathrooms 2

Business No Employees


Other

Water Supply: ✓ Individual ☐ Public ☐ Community WELL

Comments/Conditions: KEEP SYSTEM MINIMUM 100 FEET FROM WELL

Comments/Conditions: SEPTIC TANK WITH RISERS INSTALLED WITH "POLYLOK" FILTER

SCALE: 1" = 50' INITIAL SITE SKETCH

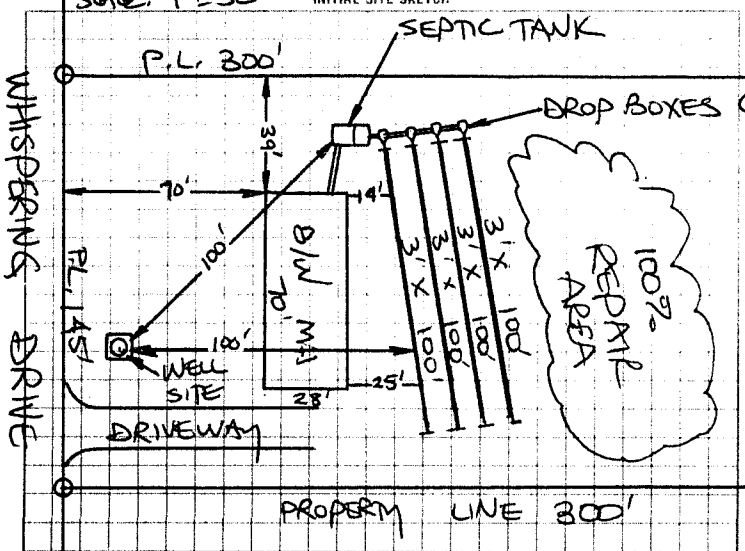

AS BUILT SKETCH

SYSTEM INSTALLED ACCORDING TO INITAL SITE SKETCH

I understand that this permit can be suspended or revoked if any false information is supplied toward securing the permit/any unauthorized changes are made to the site/any unauthorized changes are made in the installation of the system. Improvement Permit with plat valid without expiration. Improvement Permit with site plan valid for sixty months. Authorization to Construct is valid for a period equal to that of Improvement Permit – not to exceed sixty months.

Signed: Clandette Bullard date 12-10-98

Improvement Permit by: STEVE HEDRICK date 12-8-98

Authorization to Construct by: STEVE HEDRICK date 12-8-98

Installed by: A-1 BACKHOE

Operation Permit by: STEVE HEDRICK date 3-11-99

Existing System Inspection by: date

HEALTH DEPT COPY: WHITE INSPECTION COPY (FINAL): GREEN OWNER COPY (FINAL): YELLOW INSPECTION COPY (INITIAL): PINK OWNER COPY (INITIAL): GOLD