IREDELL COUNTY HEALTH DEPARTMENT

STATESVILLE 704-878-5305 (C1) MOORESVILLE 704-664-5281

IMPROVEMENT PERMIT / AUTHORIZATION TO CONSTRUCT / OPERATION PERMIT / EXISTING SYSTEM INSPECTION

PERMIT# 083421 PIN# 4863 50 0952 DATE 9-16-99

OWNER OR CONTRACTOR AMERICAN LAND PHONE: Business 878-9595 Home

ADDRESS 1281 GARNER BAGNAL BLVD, STATESVILLE NC 28677

LOCATION I-77 N, TR NC 901, TL EAGLE MILL RD, TL TRIVETTE RD (1ST), TR WHISPERING DRIVE, 6TH LOT ON LEFT

SUBDIVISION CHESHIRE RIDGE BLOCK / SECTION III LOT 28 LOT AREA 1.00 ACRE SITE CLASS PS DESIGN FLOW 360 L.T.A.R. 0.30 GPD/FT²

Septic Tank: 1000 Gallons; STB 620 Date 9-24-02
Pump Tank: ____ Gallons; PT ____ Date ____
Pump Make: ____ Model ____ Serial No. ____
Nitrification Field: No. Fields 1 Square Feet 1200 Linear Feet 400
No. Lines FOUR Trench Width 36" Max Trench Bottom Depth 22"

✓ New System Repair System Type: I II III IV V VI
System Description: CONVENTIONAL GRAVITY
Repair System Description: CONV. GRAVITY
Maintenance Agreement Required: Yes ✓ No
Gravel Depth 12"
Slab ✓ Crawl Space Basement w/plumbing Basement w/o plumbing


✓ House/Mod. Home No. Bedrooms 3
✓ Mobile Home No. Bathrooms 2
Business No. Employees
Other

Water Supply: ✓ Individual Public Community
WELL


Comments/Conditions: ① INSTALL LINES ON CONTOUR NO DEEPER THAN 22 INCHES ② KEEP SYSTEM MAXIMUM FEASIBLE DISTANCE FROM WELL (65 FEET)

Comments Conditions: SEPTIC TANK WITH RISERS INSTALLED USING "ZABEL" FILTER

INITIAL SITE SKETCH

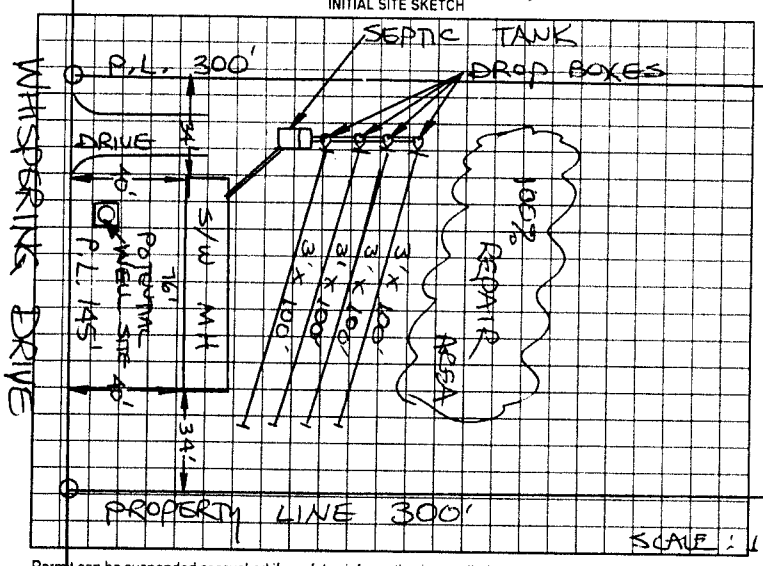

AS BUILT SKETCH

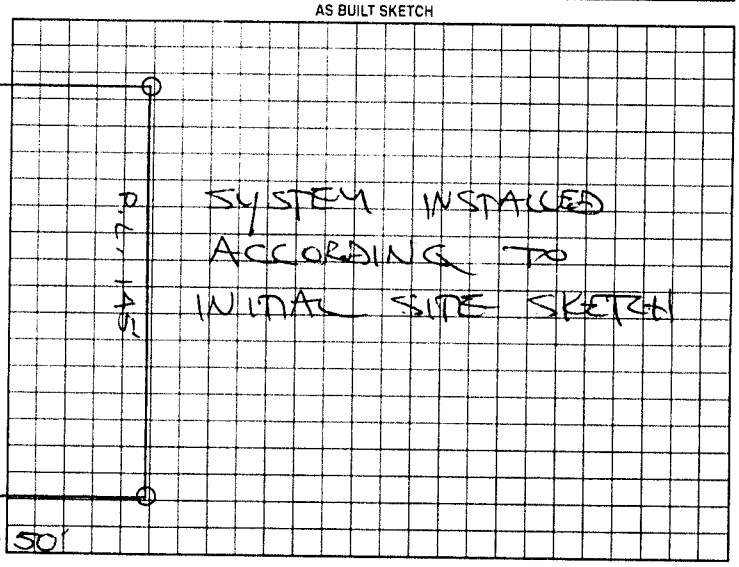

Permit can be suspended or revoked if any false information is supplied toward securing the permit/any unauthorized changes are made to the site/any unauthorized changes are made in the installation of the system. Improvement Permit with plat valid without expiration. Improvement Permit with site plan valid for sixty months. Authorization to Construct is valid for a period equal to that of Improvement Permit – not to exceed sixty months.

Signed: Sherrie Hogue-Teamster date 9-17-99 Installed by: SAMMY BEAVIS

Improvement Permit by: STEVE HEDRICK date 9-16-99 Operation Permit by STEVE HEDRICK date 11-25-02

Authorization to Construct by: STEVE HEDRICK date 9-16-99 Existing System Inspection by: ____ date ____

HEALTH DEPT COPY WHITE OWNER COPY (FINAL) YELLOW OWNER COPY (INITIAL) PINK