IREDELL COUNTY HEALTH DEPARTMENT

STATESVILLE 704-878-5305 MOORESVILLE 704-664-5281

IMPROVEMENT PERMIT / AUTHORIZATION TO CONSTRUCT / OPERATION PERMIT / EXISTING SYSTEM INSPECTION

PERMIT# 86684 PIN# 4863 50 2273 DATE 12-14-99

OWNER OR CONTRACTOR Michael Reynolds PHONE: Business _____ Home 540 628 9111

ADDRESS 23285 Stuart Dr. Abington VA

LOCATION N.C. 901 S TL Eagle Mills TL Tivoli TR Whispering Dr. 2nd lot RT

SUBDIVISION Cheshire Pike BLOCK / SECTION 3 LOT 16 LOT AREA 1.03 acres SITE CLASS PS DESIGN FLOW 360 L.T.A.R. .3

Septic Tank: 1000 Gallons STB 760 Date 10-19-99
Pump Tank: _____ Gallons; PT _____ Date _____
Pump Make: _____ Model _____ Serial No. _____
Nitrification Field: No Fields 1 Square Feet 1200 Linear Feet 400
No Lines 5 Trench Width 36" Max Trench Bottom Depth 36" Gravel Depth 12"

☑ New System ☐ Repair System Type: I II III IV V VI
System Description: Conv. Gravity
Repair System Description: Gravity 25% Red
Maintenance Agreement Required: ☐ Yes ☑ No

☐ House/Mod. Home ☑ Mobile Home ☐ Business ☐ Other
No. Bedrooms 3 No. Bathrooms 2 No. Employees _____

☑ Slab ☐ Crawl Space ☐ Basement w/plumbing ☐ Basement w/o plumbing


Water Supply: ☑ Individual ☐ Public ☐ Community

Comments/Conditions:

well next door


315'

INITIAL SITE SKETCH

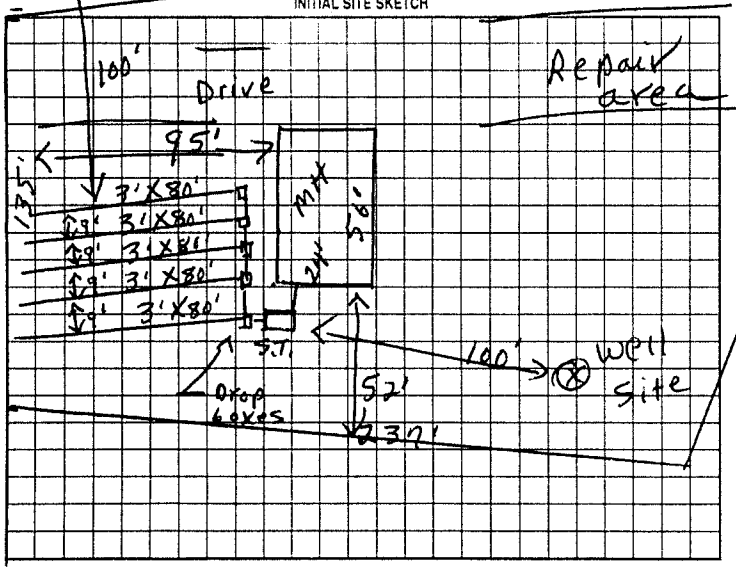

Comments/Conditions:

AS BUILT SKETCH

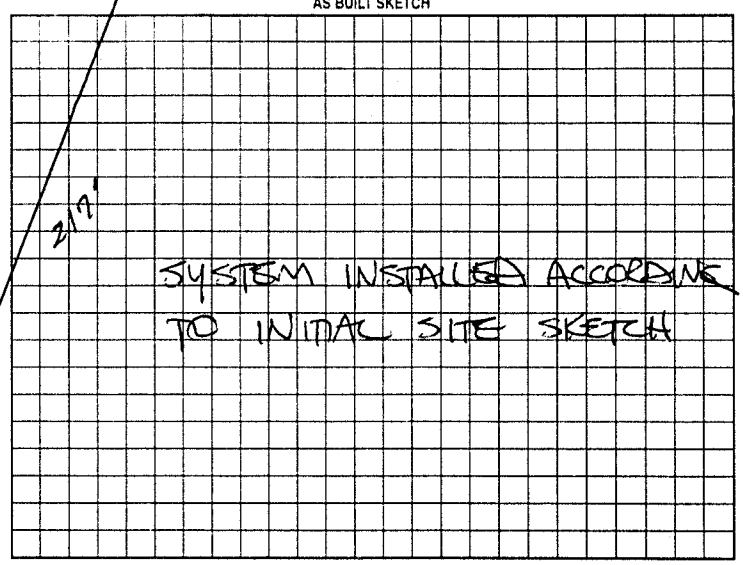

Permit can be suspended or revoked if any false information is supplied toward securing the permit/any unauthorized changes are made to the site/any unauthorized changes are made in the installation of the system. Improvement Permit with plat valid without expiration. Improvement Permit with site plan valid for sixty months. Authorization to Construct is valid for a period equal to that of Improvement Permit – not to exceed sixty months.

Signed: Keith Reynolds date _____ Installed by: RANDY MILLER

Improvement Permit by: C. Moore date 12-14-99 Operation Permit by: STEVE HERRICK date 12-30-99

Authorization to Construct by: C. Moore date 12-14-99 Existing System Inspection by: _____ date _____

HEALTH DEPT. COPY: WHITE OWNER COPY (FINAL): YELLOW OWNER COPY (INITIAL): PINK