IREDELL COUNTY HEALTH DEPARTMENT

STATESVILLE 704-878-5305 MOORESVILLE 704-664-5281

IMPROVEMENT PERMIT / AUTHORIZATION TO CONSTRUCT / OPERATION PERMIT / EXISTING SYSTEM INSPECTION

PERMIT# 081193 PIN# 4862 49 2997 DATE 5-19-99

OWNER OR CONTRACTOR JANET BALDWIN PHONE: Business Home 871-8498

ADDRESS 1207 ASCENDING LANE, STATESVILLE, NC 28625

LOCATION I-77N TO NC 901, TL EAGLE MILLS, TL TRIVETTE (1ST), TR WHISPERING, 3RD LOT ON RIGHT

SUBDIVISION CHESHIRE RIDGE BLOCK / SECTION III LOT 17 LOT AREA 1.14 ACRES SITE CLASS. PS DESIGN FLOW 360 L.T.A.R. 0.30 GPD/FT2

Septic Tank: 1000 Gallons; STB 1012 Date 4-11-99
Pump Tank: ____ Gallons; PT ____ Date ____
Pump Make: ____ Model ____ Serial No. ____
Nitrification Field: No Fields 1 Square Feet 1200 Linear Feet 400
No Lines FOUR Trench Width 36" Max Trench Bottom Depth 36" Gravel Depth 12"

☑ New System ☐ Repair System Type: ☐ I ☑ II ☐ III ☐ IV ☐ V ☐ VI
System Description: CONVENTIONAL GRAVITY
Repair System Description: CONV. GRAVITY
Maintenance Agreement Required: ☐ Yes ☑ No
☐ Slab ☐ Crawl Space ☐ Basement w/plumbing ☐ Basement wo/plumbing


☐ House/Mod. Home No. Bedrooms 3
☐ Mobile Home No. Bathrooms 2
☐ Business No. Employees ____
☐ Other ____

Water Supply: ☑ Individual ☐ Public ☐ Community WELL


Comments/Conditions: KEEP SYSTEM MINIMUM 100 FEET FROM WELL SITE

Comments/Conditions: SEPTIC TANK WITH RISERS INSTALLED USING "POLYLOK" FILTER

SCALE: 1" = 50' INITIAL SITE SKETCH

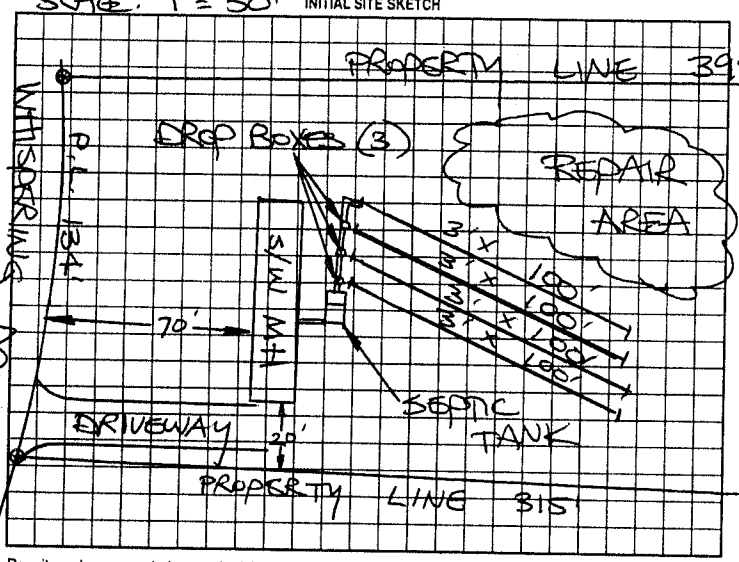

AS BUILT SKETCH

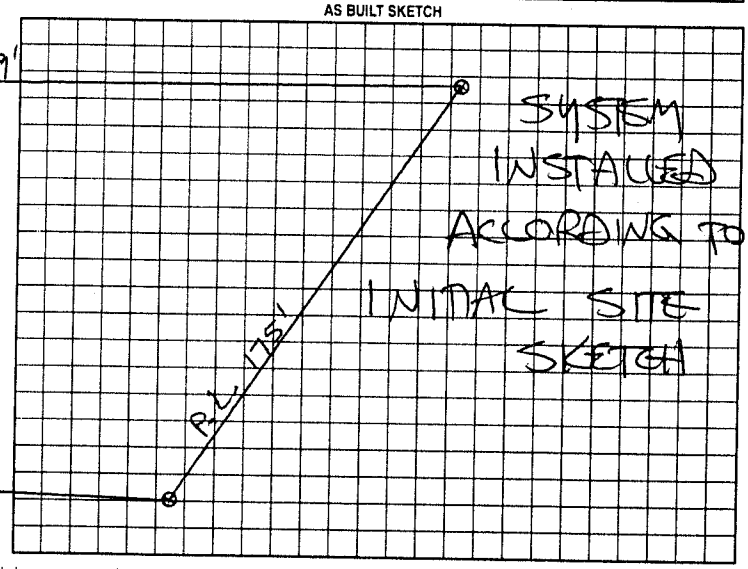

Permit can be suspended or revoked if any false information is supplied toward securing the permit/any unauthorized changes are made to the site/any unauthorized changes are made in the installation of the system. Improvement Permit with plat valid without expiration. Improvement Permit with site plan valid for sixty months. Authorization to Construct is valid for a period equal to that of Improvement Permit – not to exceed sixty months.

Signed: X Janet Baldwin date 5-19-99

Improvement Permit by: STEVE HEDRICK date 5-19-99

Authorization to Construct by: STEVE HEDRICK date 5-19-99

Installed by: A-1 BACK HOE

Operation Permit by: STEVE HEDRICK date 5-27-99

Existing System Inspection by: ____ date ____

HEALTH DEPT. COPY: WHITE OWNER COPY (FINAL): YELLOW OWNER COPY (INITIAL): PINK