IREDELL COUNTY HEALTH DEPARTMENT

STATESVILLE 704-878-5305 MOORESVILLE 704-664-5281

IMPROVEMENT PERMIT / AUTHORIZATION TO CONSTRUCT / OPERATION PERMIT / EXISTING SYSTEM INSPECTION

PERMIT# 089860 PIN# 4863 50 3962 DATE 7-6-2000

OWNER OR CONTRACTOR AMERICAN LAND CORP PHONE: Business 878-9595 Home

ADDRESS 3126 MILTON ROAD, STE 227 CHARLOTTE NC 28215

LOCATION US 21 N, TL NC901, TR EAGLE MILLS, TL TRUETTE (1ST), TR WHISPERING PINE, 7TH LOT ON RIGHT

SUBDIVISION CHESHIRE RIDGE BLOCK / SECTION III LOT 21 LOT AREA 1.00 ACRE SITE CLASS: PS DESIGN FLOW 360 L.T.A.R. 0.30 GPD/FT²

Septic Tank: 1000 Gallons; STB 6-24-00 Date 3/2

Pump Tank: Gallons; PT Date

Pump Make: Model Serial No.

Nitrification Field: No Fields 1 Square Feet 200 Linear Feet 300+

No Lines SIX Trench Width 36" Max Trench Bottom Depth 30"

☑ New System ☐ Repair System Type: I, II, III, IV, V, VI

System Description: 25% REDUCTION GRAVITY

Repair System Description: 50% REDUCTION GRAVITY

Maintenance Agreement Required: ☐ Yes ☒ No

~~Gravel~~ Depth SAND 6" ☐ Slab ☒ Crawl Space ☐ Basement w/plumbing ☐ Basement wo/plumbing

☐ House/Mod. Home ☒ Mobile Home ☐ Business ☐ Other

No. Bedrooms 3 No. Bathrooms 2 No. Employees


Water Supply: ☑ Individual ☐ Public ☐ Community WELL

Comments/Conditions: ① KEEP SYSTEM MINIMUM 100 FEET FROM WELL ② INSTALL 25% REDUCTION SYSTEM USING FIFTY (50) CHAMBERS OR THIRTY (30) HDS SECTIONS


Comments/Conditions:

* Note Driveway switched to opposite side

INITIAL SITE SKETCH SCALE: 1"=50'

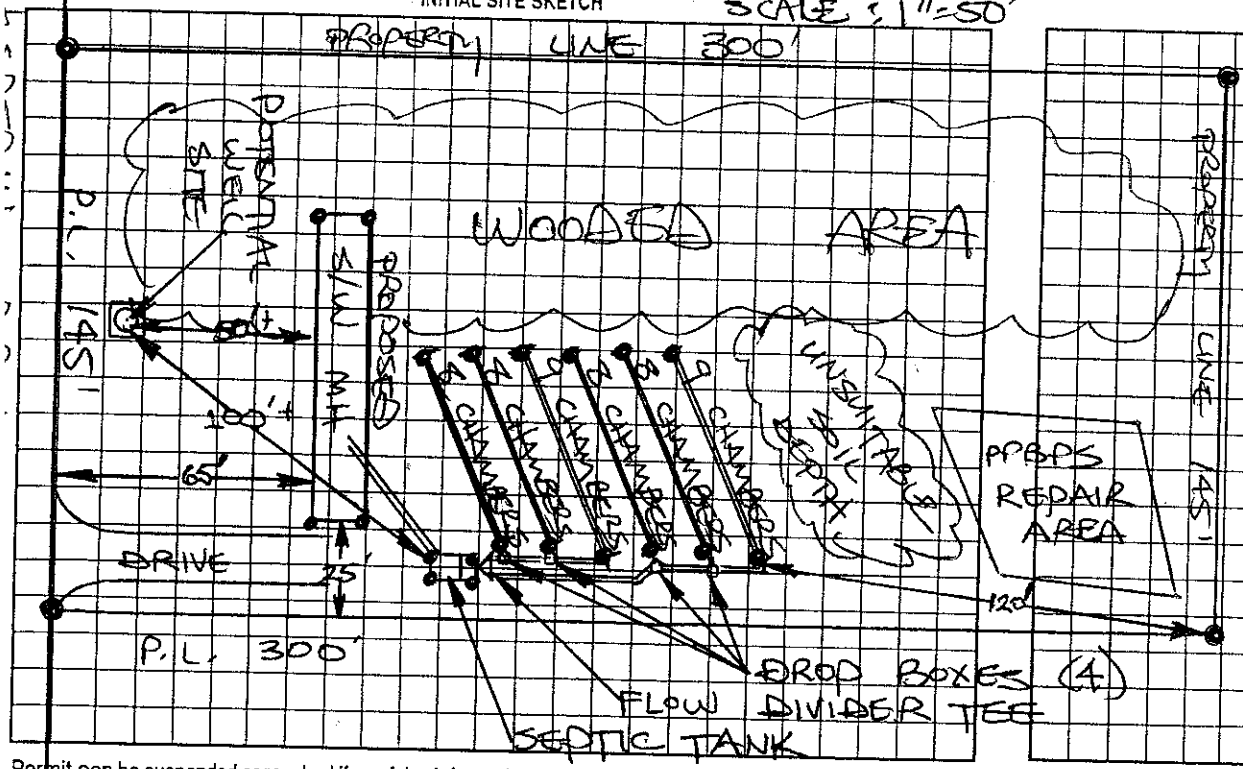

AS BUILT SKETCH

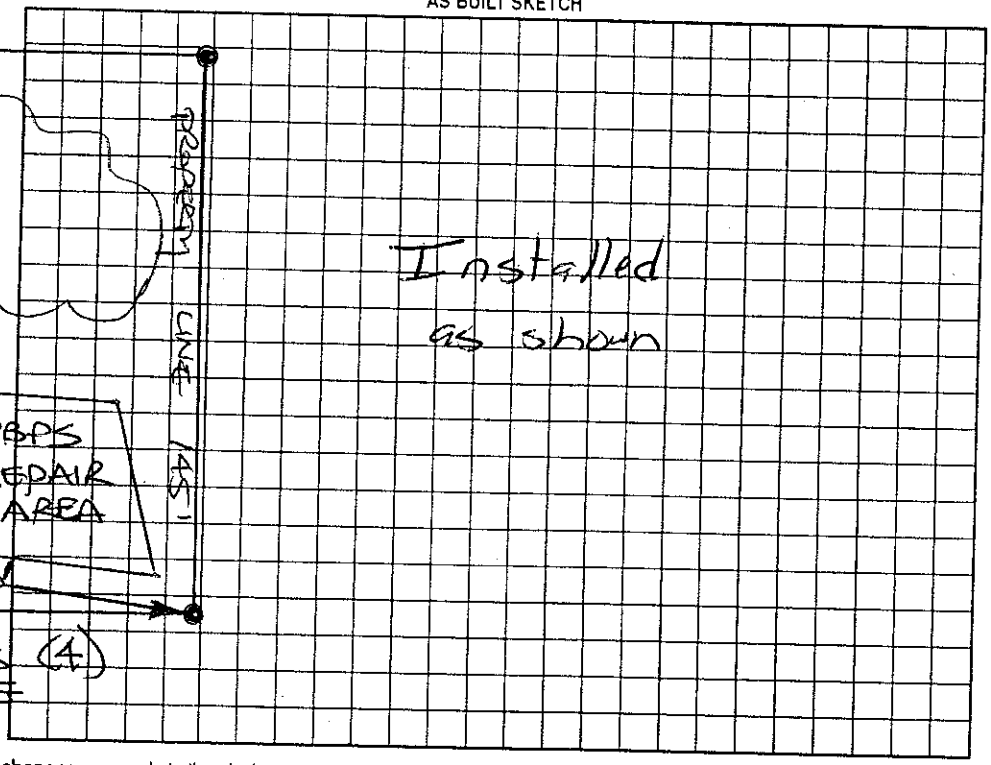

Permit can be suspended or revoked if any false information is supplied toward securing the permit/any unauthorized changes are made to the site/any unauthorized changes are made in the installation of the system. Improvement Permit with plat valid without expiration. Improvement Permit with site plan valid for sixty months. Authorization to Construct is valid for a period equal to that of Improvement Permit – not to exceed sixty months.

Signed: 7-10-2000 date 7-10-2000 Installed by: Upright Grading

Improvement Permit by: STEVE HEDRICK date 7-6-2000 Operation Permit by: [illegible] date 8-1-00

Authorization to Construct by: STEVE HEDRICK date 7-6-2000 Existing System Inspection by: date

HEALTH DEPT. COPY: WHITE OWNER COPY (FINAL): YELLOW OWNER COPY (INITIAL): PINK