IREDELL COUNTY HEALTH DEPARTMENT

STATESVILLE 704-878-5305 MOORESVILLE 704-664-5281

IMPROVEMENT PERMIT / AUTHORIZATION TO CONSTRUCT / OPERATION PERMIT / EXISTING SYSTEM INSPECTION

PERMIT# 80924 PIN# 4863 50 4429 DATE 5-17-99

OWNER OR CONTRACTOR Robert H. Willard PHONE: Business Home 924 9393

ADDRESS 510 A. Armfield St. Statesville N.C.

LOCATION 901 E TL Eagle Mill TL Ivivette Th Whispering Ln 4th lot Rt.

SUBDIVISION Cheshire Ridge BLOCK / SECTION III LOT 18 LOT AREA 1.28 acres SITE CLASS. PS DESIGN FLOW L.T.A.R. .3

Septic Tank: 1000 Gallons; STB 1012 Date 4/13/99

Pump Tank: Gallons; PT Date

Pump Make: Model Serial No.

Nitrification Field: No Fields 1 Square Feet 1200 Linear Feet 400

No Lines 4 Trench Width 36" Max Trench Bottom Depth 36" Gravel Depth 12"

☑ New System ☐ Repair System Type: I, II, III, IV, V, VI

System Description: Conv. Gravity

Repair System Description: " "

Maintenance Agreement Required: ☐ Yes ☑ No

☐ House/Mod. Home ☑ Mobile Home ☐ Business ☐ Other

No. Bedrooms 3 No. Bathrooms 2 No. Employees

Water Supply: ☑ Individual ☐ Public ☐ Community


☐ Slab ☑ Crawl Space ☐ Basement w/plumbing ☐ Basement wo/plumbing

Comments:/Conditions:


Comments:/Conditions:

493'

INITIAL SITE SKETCH

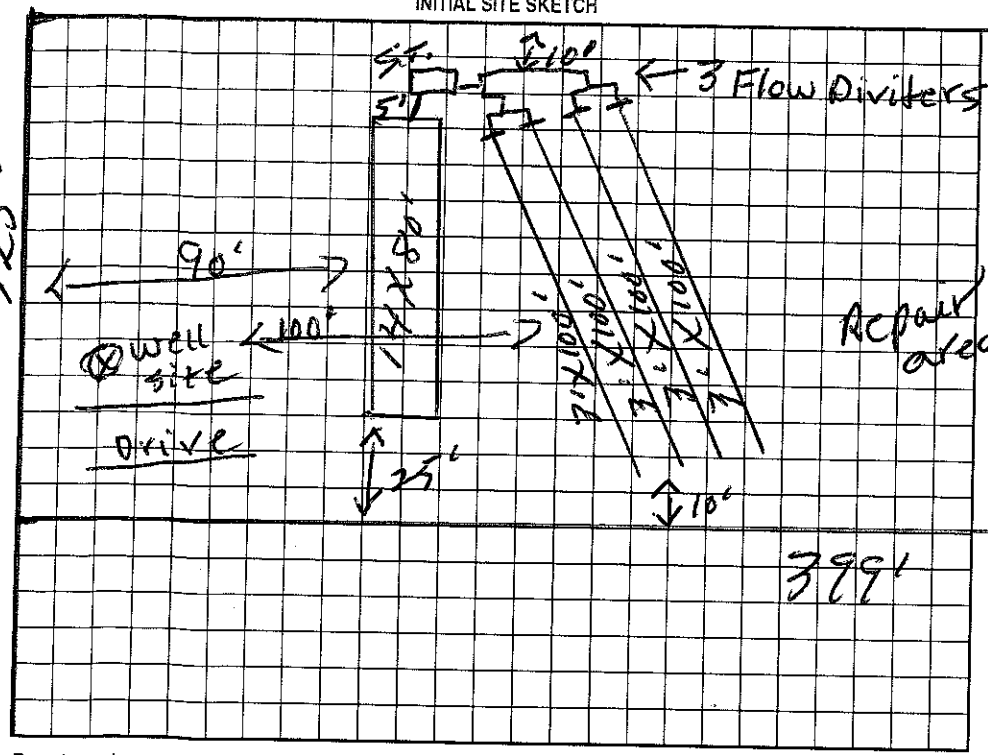

AS BUILT SKETCH

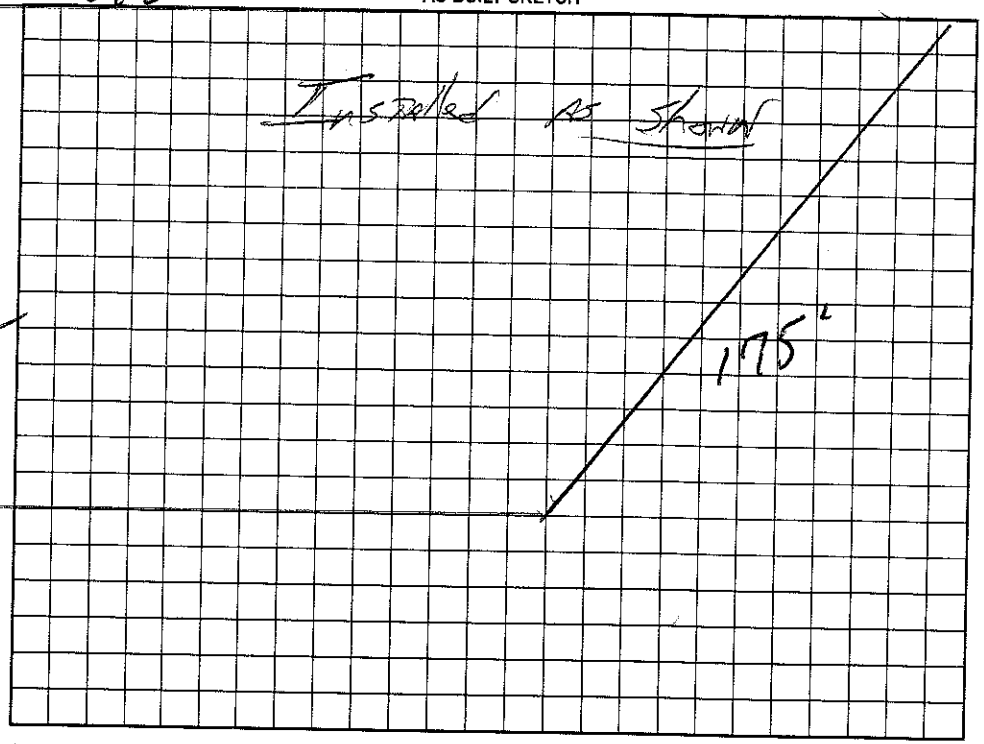

Permit can be suspended or revoked if any false information is supplied toward securing the permit/any unauthorized changes are made to the site/any unauthorized changes are made in the installation of the system. Improvement Permit with plat valid without expiration. Improvement Permit with site plan valid for sixty months. Authorization to Construct is valid for a period equal to that of Improvement Permit – not to exceed sixty months.

Signed: Shellie Hedrick-Teasley date 5-18-99 Installed by: A1 Backhoe

Improvement Permit by: R. C. Moore date 5-17-99 Operation Permit by: Joe Potter date 5-20-99

Authorization to Construct by: R. C. Moore date 5-17-99 Existing System Inspection by: date

HEALTH DEPT. COPY: WHITE OWNER COPY (FINAL): YELLOW OWNER COPY (INITIAL): PINK