IREDELL COUNTY HEALTH DEPARTMENT

STATESVILLE 704-878-5305 MOORESVILLE 704-664-5281

IMPROVEMENT PERMIT / AUTHORIZATION TO CONSTRUCT / OPERATION PERMIT / EXISTING SYSTEM INSPECTION

PERMIT# 080555 PIN# 4863504761 DATE 4-15-99

OWNER OR CONTRACTOR RANAY GILKESON PHONE: Business 878-9595 Home

ADDRESS 317 TALBERT ROAD, MOORESVILLE, NC 28117

LOCATION I-77 N, TL EAGLE MILLS, TL TRIVETTE (1ST), TR WHISPERING DRIVE, 5TH LOT ON RIGHT

SUBDIVISION CHESHIRE RIDGE BLOCK / SECTION III LOT 19 LOT AREA 1.55 ACRE SITE CLASS PS DESIGN FLOW 360 L.T.A.R. 0.25 GPD/FT2

Septic Tank: 1000 Gallons; STB 1012 Date 3-28-99
Pump Tank: Gallons; PT Date
Pump Make: Model Serial No.
Nitrification Field: No Fields 1 Square Feet 1440 Linear Feet 480
No Lines SIX Trench Width 36" Max Trench Bottom Depth 24" Gravel Depth 12"

☑ New System ☐ Repair System Type: I II III IV V VI
System Description: CONVENTIONAL GRAVITY
Repair System Description: CONV. GRAVITY
Maintenance Agreement Required: ☐ Yes ☑ No


☐ Slab ☑ Crawl Space ☐ Basement w/plumbing ☐ Basement wo/plumbing

☐ House/Mod. Home ☑ Mobile Home ☐ Business ☐ Other
No. Bedrooms 3 No. Bathrooms 2 No. Employees

Water Supply: ☑ Individual ☐ Public ☐ Community WELL


Comments/Conditions: ① CONSTRUCT SUBSURFACE DIVERSION INTERCEPT DRAINAGE DITCH AT LOCATION SHOWN BEGINNING 40" DEEP OUT TO DAYLIGHT. ② KEEP SYSTEM MINIMUM 100' FROM WELL.

INITIAL SITE SKETCH

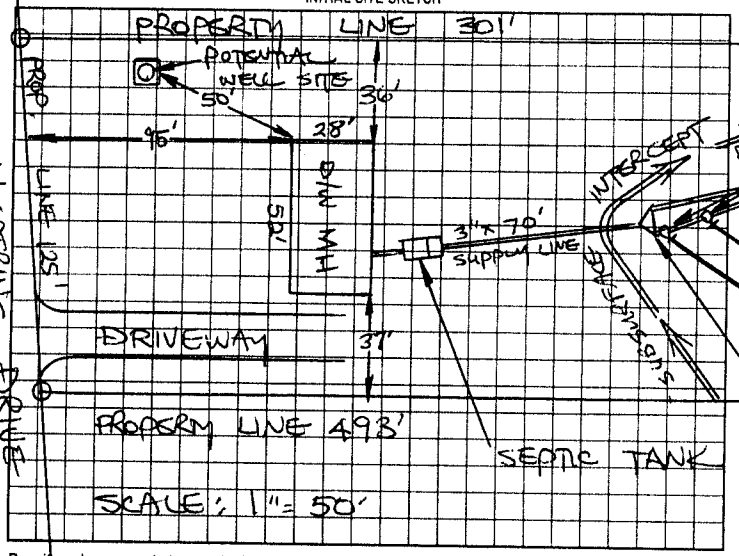

Comments/Conditions: SEPTIC TANK W/ RISERS INSTALLED USING "POLYLOK" FILTER & LINES 5-3-99 SUBSURFACE INTERCEPT DRAINAGE DITCH TO BE INSTALLED 5-3-99

AS BUILT SKETCH

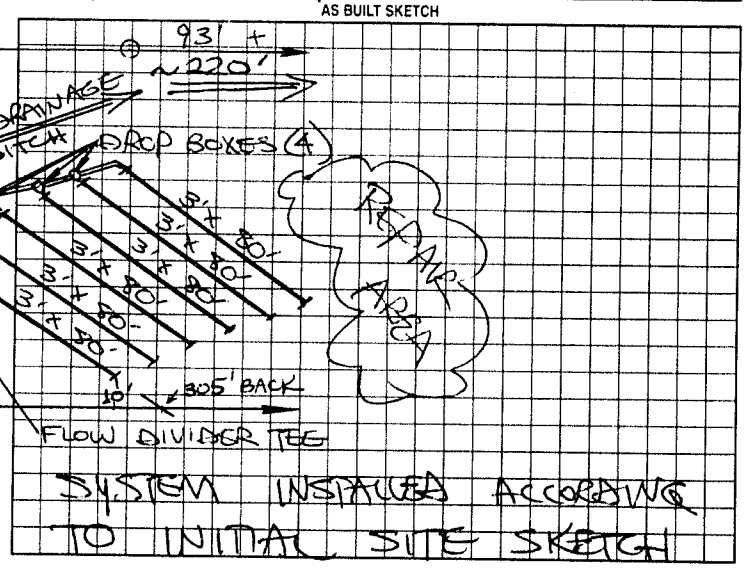

Permit can be suspended or revoked if any false information is supplied toward securing the permit/any unauthorized changes are made to the site/any unauthorized changes are made in the installation of the system. Improvement Permit with plat valid without expiration. Improvement Permit with site plan valid for sixty months. Authorization to Construct is valid for a period equal to that of Improvement Permit – not to exceed sixty months.

Signed Juanita Gilkeson date 4-15-99 Installed by: A-1 BACKHOE

Improvement Permit by: STEVE HEDRICK date 4-15-99 Operation Permit by: STEVE HEDRICK date 5-3-99

Authorization to Construct by: STEVE HEDRICK date 4-15-99 Existing System Inspection by: date

HEALTH DEPT COPY WHITE OWNER COPY (FINAL) YELLOW OWNER COPY (INITIAL) PINK