IREDELL COUNTY HEALTH DEPARTMENT

STATESVILLE 704-878-5305 MOORESVILLE 704-664-5281

IMPROVEMENT PERMIT / AUTHORIZATION TO CONSTRUCT / OPERATION PERMIT / EXISTING SYSTEM INSPECTION

PERMIT#: 137563 PIN#: 4863504671 DATE: 8/30/06

OWNER OR APPLICANT: Sergio Martinez PHONE: Business 704 546 5596 Home 704 232 9777

ADDRESS: 136 Whispering Dr

LOCATION: R on Rd 177 N (R) on 901, (L) on Winthrop, (L) on Crider, (R) on Cartwright, (L) on Trivette, (R) on Whispering, Prop on (R)

SUBDIVISION: Cheshire Ridge BLOCK / SECTION: III LOT: 19 LOT AREA: 1.55 SITE CLASS: PS DESIGN FLOW: 360 L.T.A.R.: .25

Septic Tank: Ex. Gallons: STB Ex. Date: Ex.
Pump Tank: Gallons: PT Date:
Pump Make: Model: Serial No.:
Nitrification Field: No Fields Ex Square Feet Ex Linear Feet Ex.
No Lines Ex. Trench Width Ex Max Trench Bottom Depth Ex. Gravel Depth Ex

■ New System ☐ Repair ☐ Expansion System Type: I (II) III IV V VI
System Description: Ex. Conv. Gravity
Repair System Description: Ex.
Maintenance Agreement Required: ☐ Yes ☐ No

☐ House/Mod. Home ☒ Mobile Home ☐ Business ☐ Other
No. Bedrooms 3 No. Persons No. Employees


Water Supply: ☒ Individual ☐ Public ☐ Community

☒ Gravity ☐ Pressure ☐ Slab ☐ Crawl Space ☐ Basement w/plumbing ☐ Basement wo/plumbing


Comments:/Conditions:
Replace Broken Riser Cap on Outlet end of tank
Clean Filter in Septic Tank

Comments:/Conditions:

INITIAL SITE SKETCH

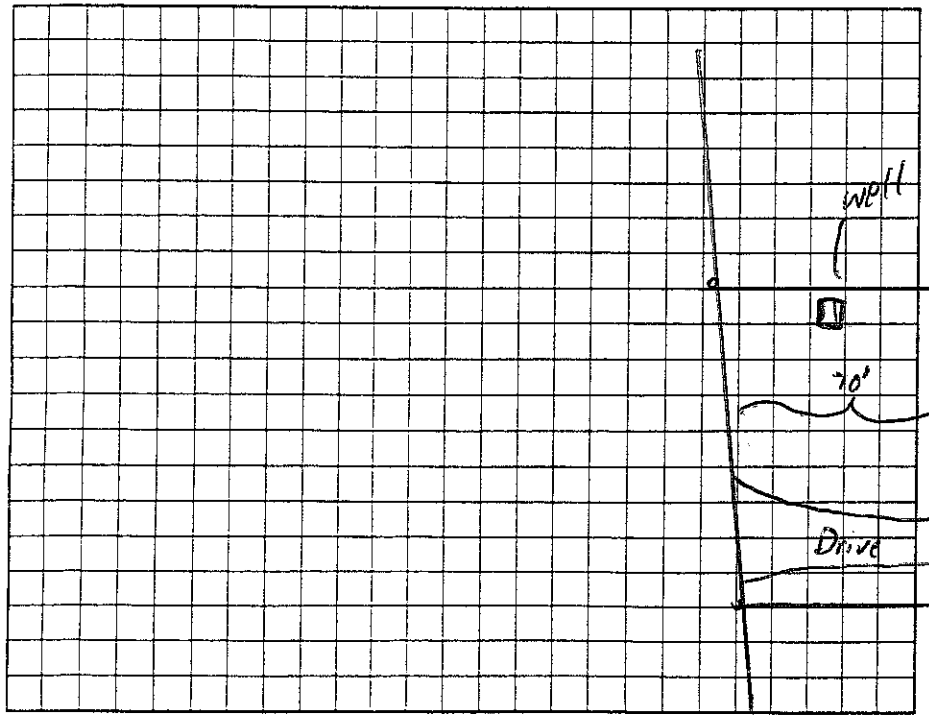

AS BUILT SKETCH

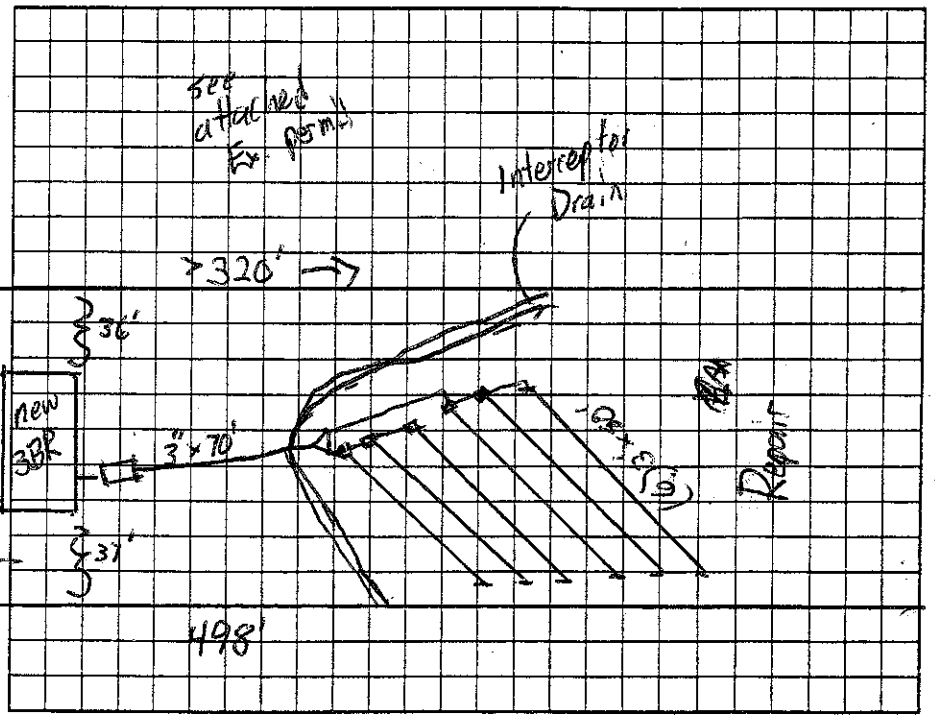

Permit can be suspended or revoked if any false information is supplied toward securing the permit/any unauthorized changes are made to the site/any unauthorized changes are made in the installation of the system. Improvement Permit with plan valid without expiration ☐ Improvement Permit with site plan valid for sixty months ☐ Authorization to Construct is valid for a period equal to that of Improvement Permit – not to exceed sixty months.

Signed: Brandy Carriker date 9/1/06

Improvement Permit by: date

Authorization to Construct by: date

Installed by:

Operation Permit by: date

Existing System Inspection by: James date 8-30-06

HEALTH DEPT. COPY: WHITE OWNER COPY (FINAL): YELLOW OWNER COPY (INITIAL): PINK