IREDELL COUNTY HEALTH DEPARTMENT

STATESVILLE 704-878-5305 MOORESVILLE 704-664-5281

IMPROVEMENT PERMIT / AUTHORIZATION TO CONSTRUCT / OPERATION PERMIT / EXISTING SYSTEM INSPECTION

PERMIT# 091058 PIN# 4863 50 6956 DATE 11-9-00

OWNER OR CONTRACTOR ANNA KUPKA PHONE: Business Home (704) 855-9817

ADDRESS 555 CORINTH CHURCH ROAD, MOORESVILLE NC 28115

LOCATION I-77 N, TR NC 901, TL EAGLE MILLS RD, TL TRNETTE RD (1ST), TL NATURES WAY, TL SCENIC POINT

SUBDIVISION CHESHIRE RIDGE BLOCK / SECTION III LOT 10 LOT AREA 1.90 ACRES SITE CLASS PS DESIGN FLOW 360 L.T.A.R. 0.30 GPD/FT²

Septic Tank: 1000 Gallons; STB ____ Date ____

Pump Tank: ____ Gallons; PT ____ Date ____

Pump Make: ____ Model ____ Serial No. ____

Nitrification Field: No Fields 1 Square Feet EQ. TO 1200 Linear Feet 300+

No Lines FOUR Trench Width 36" Max Trench Bottom Depth 30" ~~Gravel~~ Depth SAND 6"

✓ New System ☐ Repair System Type: I II (III) IV V VI

System Description: 25% REDUCTION GRAVITY

Repair System Description: CONVENTIONAL, PUMP

Maintenance Agreement Required: Yes ✓ No

☐ House/Mod. Home No. Bedrooms 3

✓ Mobile Home No. Bathrooms 2

☐ Business No. Employees ____

☐ Other 3BR, 2 BATH


☐ Slab ✓ Crawl Space ☐ Basement w/plumbing ☐ Basement wo/plumbing

Water Supply: ✓ Individual ☐ Public ☐ Community WELL


Comments/Conditions: ① INSTALL 25% REDUCTION SYSTEM USING FIFTY (50) CHAMBERS (AT REQUEST) AS SHOWN ② INSTALL SUBSURFACE INTERCEPT DRAINAGE DITCH BEGINNING 42" DEEP TO DAYLIGHT

Comments/Conditions ① SEPTIC TANK W/ MARKER INSTALLED USING "TUFFITE" FILTER

INITIAL SITE SKETCH

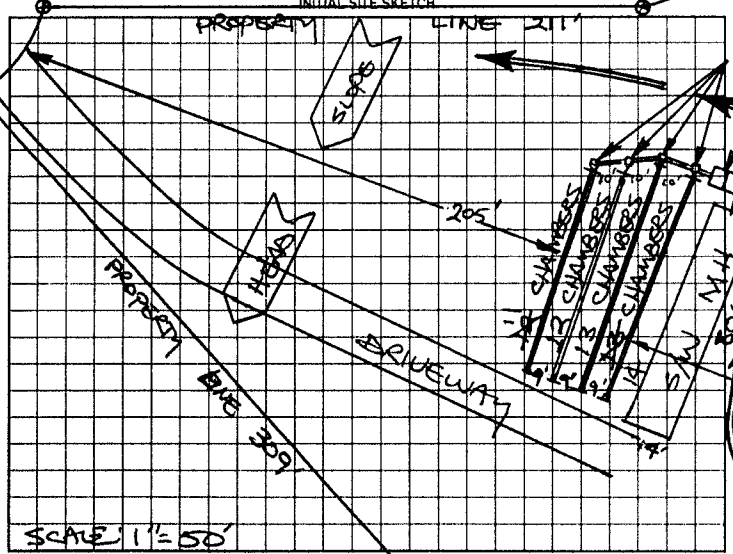

AS BUILT SKETCH

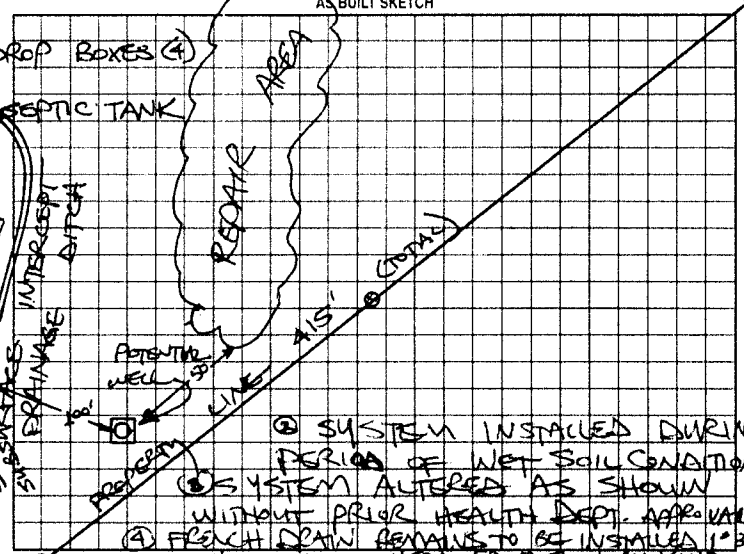

Permit can be suspended or revoked if any false information is supplied toward securing the permit/any unauthorized changes are made to the site/any unauthorized changes are made in the installation of the system. Improvement Permit with plat valid without expiration. Improvement Permit with site plan valid for sixty months. Authorization to Construct is valid for a period equal to that of Improvement Permit – not to exceed sixty months.

Signed: Anna Marie Dupy Kupka date 11-13-00

Improvement Permit by: STEVE HEDRICK date 11-9-00

Authorization to Construct by: STEVE HEDRICK date 11-9-00

Installed by: TUCKERS HAULING & GRADING AND KEITH'S WELL DRILLING

Operation Permit by: STEVE HEDRICK date 5-7-01

Existing System Inspection by: ____ date ____

HEALTH DEPT COPY WHITE OWNER COPY (FINAL) YELLOW OWNER COPY (INITIAL) PINK