THIS PERMIT VOIDS PREVIOUS ISSUED 12-9-98

IREDELL COUNTY HEALTH DEPARTMENT

STATESVILLE 704-878-5305 MOORESVILLE 704-664-5281

IMPROVEMENT PERMIT / AUTHORIZATION TO CONSTRUCT / OPERATION PERMIT / EXISTING SYSTEM INSPECTION

PERMIT# 078003 PIN# 4863 50 2713 (PART) DATE 3-21-00

OWNER OR CONTRACTOR TONY CILETTI PHONE: Business _____ Home 367-9229

ADDRESS 1329 DRANE AVE, CHARLOTTE NC 28211

LOCATION I-77 N, TR NC 901, TL EAGLE MILLS ROAD, TL NATURE'S WAY, TL SCENIC POINT, AT END ON LEFT

SUBDIVISION CHESHIRE RIDGE BLOCK / SECTION III LOT 12 LOT AREA 1.00 ACRE SITE CLASS IPS DESIGN FLOW 360 L.T.A.R. 0.30 GPD/FT²

Septic Tank: 1000 Gallons; STB 1012 Date 5-30-00
Pump Tank: 1000 Gallons; PT 17 Date 7-17-00
Pump Make: HYDROMATIC Model SHEF50A Serial No. _____
Nitrification Field: No Fields 1 Square Feet EQ. TO 1200 Linear Feet 200
No Lines FIVE Trench Width 24" Max Trench Bottom Depth 36" ~~Bored~~ Depth SAND 6"

☑ New System ☐ Repair System Type: I, II, III, IV, V, VI
System Description: PPBPS, PUMP-FED
Repair System Description: PPBPS, LOW PRESS
Maintenance Agreement Required: ☐ Yes ☑ No

☐ House/Mod. Home ☑ Mobile Home ☐ Business ☐ Other
No. Bedrooms 3 No. Bathrooms 2 No. Employees ____


☐ Slab ☑ Crawl Space ☐ Basement w/plumbing ☐ Basement wo/plumbing

Water Supply: ☑ Individual ☐ Public ☐ Community WELL

Comments/Conditions: ① KEEP SYSTEM MINIMUM 100' FROM WELL
② INSTALL 50% REDUCTION SYSTEM USING 45 PPBPS PANELS IN 5 EQUAL LENGTH LINES ON CONTOUR AS FLAGGED.
③ SEE ATTACHED SHEETS FOR PUMP & PRESSURE MANIFOLD REQUIREMENTS.

Comments/Conditions: SEPTIC TANK WITH RISERS INSTALLED USING "POLYLOK" FILTER

INITIAL SITE SKETCH

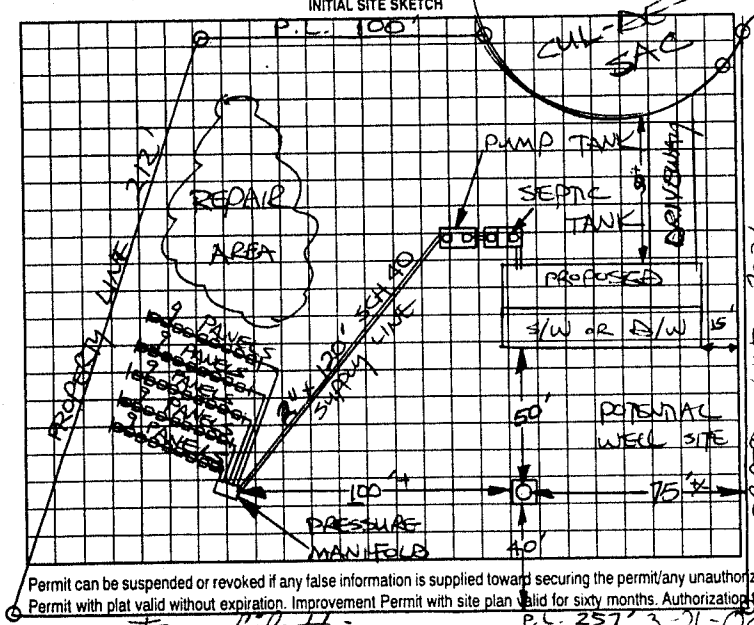

AS BUILT SKETCH

SYSTEM INSTALLED ACCORDING TO INITAL SITE SKETCH

Permit can be suspended or revoked if any false information is supplied toward securing the permit/any unauthorized changes are made to the site/any unauthorized changes are made in the installation of the system. Improvement Permit with plat valid without expiration. Improvement Permit with site plan valid for sixty months. Authorization to Construct is valid for a period equal to that of Improvement Permit – not to exceed sixty months.

Signed: + Tony Ciletti date 3-21-00 Installed by: A-1 BACKHOE

Improvement Permit by: STEVE HENDRICK date 3-21-00 Operation Permit by: STEVE HENDRICK date 8-23-00

Authorization to Construct by: STEVE HENDRICK date 3-21-00 Existing System Inspection by: _____ date _____

HEALTH DEPT. COPY: WHITE OWNER COPY (FINAL): YELLOW OWNER COPY (INITIAL): PINK