IREDELL COUNTY HEALTH DEPARTMENT

STATESVILLE 704-878-5305 MOORESVILLE 704-664-5281

IMPROVEMENT PERMIT / AUTHORIZATION TO CONSTRUCT / OPERATION PERMIT / EXISTING SYSTEM INSPECTION

PERMIT# 078348 PIN# 4863 50 2713 (PART) DATE 12-7-98

OWNER OR CONTRACTOR BRYAN WATKINS PHONE: Business Home 902-9854

ADDRESS P.O. Box 21, UNION GROVE NC 28689

LOCATION I-77N, TR NC 901, TL CRATER, TR CARTWRIGHT, TL TRIVETTE, TR WHISPERING PINES, AT END ON (L)

SUBDIVISION ~~CHESHIRE RIDGE~~ BLOCK / SECTION III LOT 27 LOT AREA 1.00 ACRE SITE CLASS PS DESIGN FLOW 360 L.T.A.R. 0.30 GPD/FT²

Septic Tank: 1000 Gallons: STB 620 Date 12-10-98
Pump Tank: Gallons: PT Date
Pump Make: Model Serial No
Nitrification Field: No. Fields 1 Square Feet/Ft. To 1200 Linear Feet 300
No. Lines FIVE Trench Width 36" Max. Trench Bottom Depth 30"

✓ New System Repair System Type: I II III IV V
System Description 25% REDUCTION GRAVITY
Repair System Description 25% REDUCTION GRAVITY
Maintenance Agreement Required Yes ✓ No ✓
Depth: SHWT 6" Slope ✓ Crawl Space Basement w/plumbing Basement w/o plumbing


✓ House/Mod. Home No. Bedrooms 3
✓ Mobile Home No. Bathrooms 2
Business No. Employees
Other

Water Supply:
✓ Individual
Public
Community
WELL

Comments/Conditions: ① KEEP SYSTEM MINIMUM 100 FEET FROM WELL ② INSTALL 25% REDUCTION SYSTEM USING FIFTY CHAMBERS (6') OR THIRTY H.D.S. SECTIONS (10') ON CONTOUR AS SHOWN.

Comments/Conditions:

INITIAL SITE SKETCH SCALE: 1" = 40'

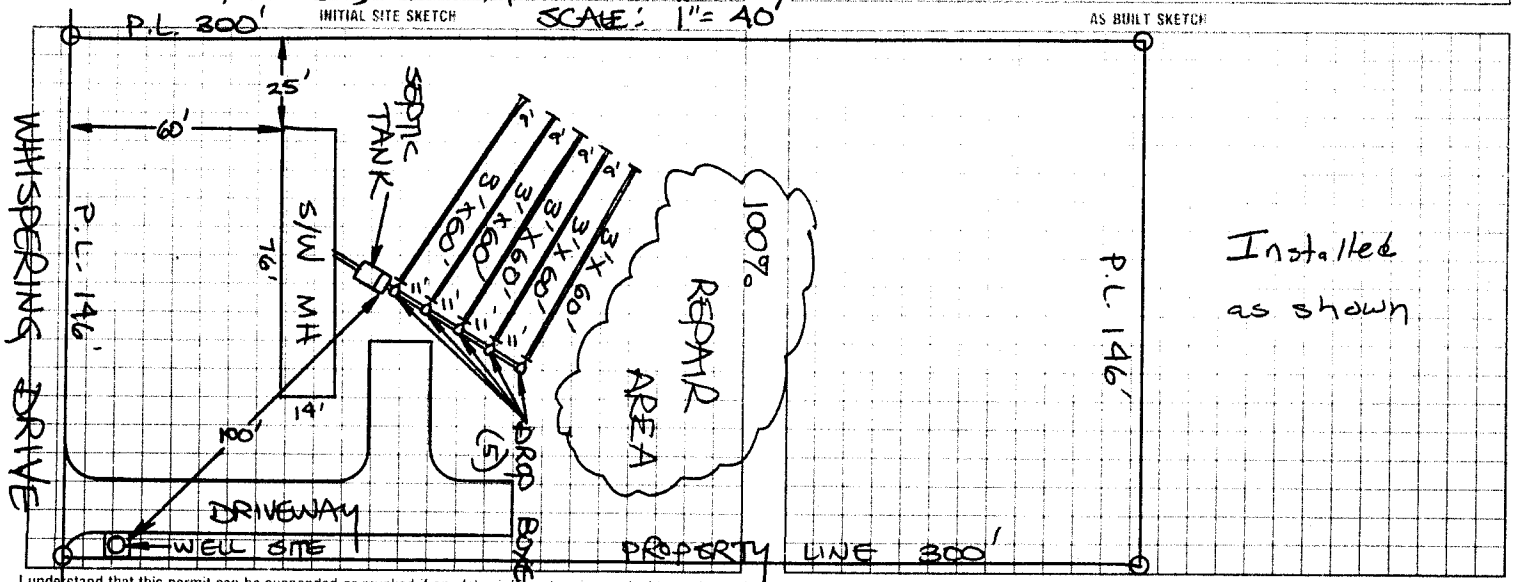

AS BUILT SKETCH

I understand that this permit can be suspended or revoked if any false information is supplied toward securing the permit/any unauthorized changes are made to the site/any unauthorized changes are made in the installation of the system. Improvement Permit with plat valid without expiration. Improvement Permit with site plan valid for sixty months. Authorization to Construct is valid for a period equal to that of Improvement Permit – not to exceed sixty months.

Signed: Elizabeth L Watkins date 12-7-98 Installed by: Brent Galliher

Improvement Permit by: STEVE HEDRICK date 12-7-98 Operation Permit by: Mary C Watts RS date 3-11-99

Authorization to Construct by: STEVE HEDRICK date 12-7-98 Existing System Inspection by: date

HEALTH DEPT. COPY: WHITE INSPECTION COPY (FINAL): GREEN OWNER COPY (FINAL): YELLOW INSPECTION COPY (INITIAL): PINK OWNER COPY (INITIAL): GOLD