IREDELL COUNTY HEALTH DEPARTMENT

STATESVILLE 704-878-5305 MOORESVILLE 704-664-5281

IMPROVEMENT PERMIT / AUTHORIZATION TO CONSTRUCT / OPERATION PERMIT / EXISTING SYSTEM INSPECTION

PERMIT# 083475 PIN# 4863 51 3369 DATE 10-12-99

OWNER OR CONTRACTOR AMERICAN LAND PHONE: Business 878-9595 Home

ADDRESS 1281 GARNER BAGNAL BLVD, STATESVILLE, NC 28677

LOCATION I-77N, TR NC 901, TL EAGLE MILLS RD, TL TRIVETTE (1ST), TR WHISPERING DRIVE, LOT AT END

SUBDIVISION CHESHIRE RIDGE BLOCK / SECTION III LOT 24 LOT AREA 1.36 ACRES SITE CLASS PS DESIGN FLOW 300 L.T.A.R. 0.30 GPD/FT²

Septic Tank: 1000 Gallons; STB 1015 Date 8-13-99
Pump Tank: ____ Gallons; PT ____ Date ____
Pump Make: ____ Model ____ Serial No ____
Nitrification Field: No Fields 1 Square Feet EQ TO 1200 Linear Feet 300+
No Lines THREE Trench Width 36" Max Trench Bottom Depth 36" ~~Gravel~~ Depth SAND 6"

☑ New System ☐ Repair System Type: I. II (III) IV. V. VI
System Description: 25% REDUCTION GRAVITY
Repair System Description: 25% REDUCTION GRAVITY
Maintenance Agreement Required: ☐ Yes ☑ No
☐ Slab ☑ Crawl Space ☐ Basement w/plumbing ☐ Basement wo/plumbing

☐ House/Mod. Home No. Bedrooms 3
☑ Mobile Home No. Bathrooms 2
☐ Business No. Employees ____
☐ Other ____


Water Supply:
☑ Individual
☐ Public
☐ Community
WELL

Comments/Conditions ① INSTALL 25% REDUCTION SYSTEM USING 50 CHAMBERS OR 30 HDS SECTIONS
② KEEP SYSTEM MINIMUM 100 FEET FROM WELL


Comments/Conditions SEPTIC TANK WITH MARKER INSTALLED USING "POLYLOK" FILTER

SCALE: 1"=50'

INITIAL SITE SKETCH

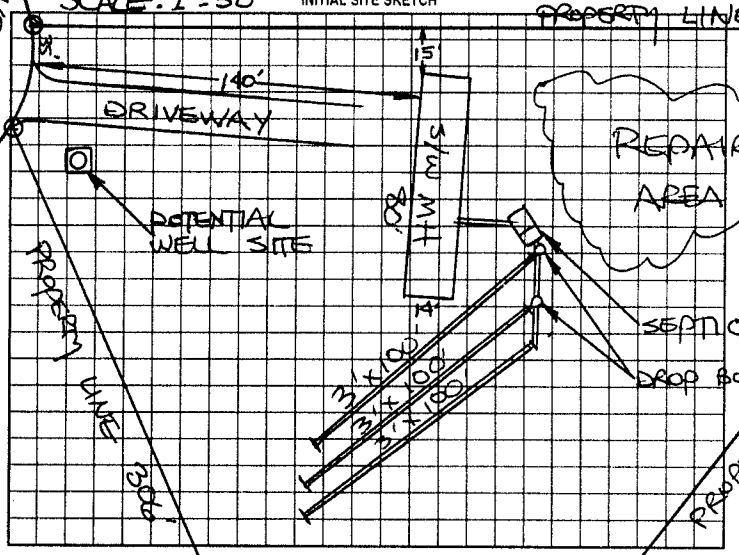

AS BUILT SKETCH

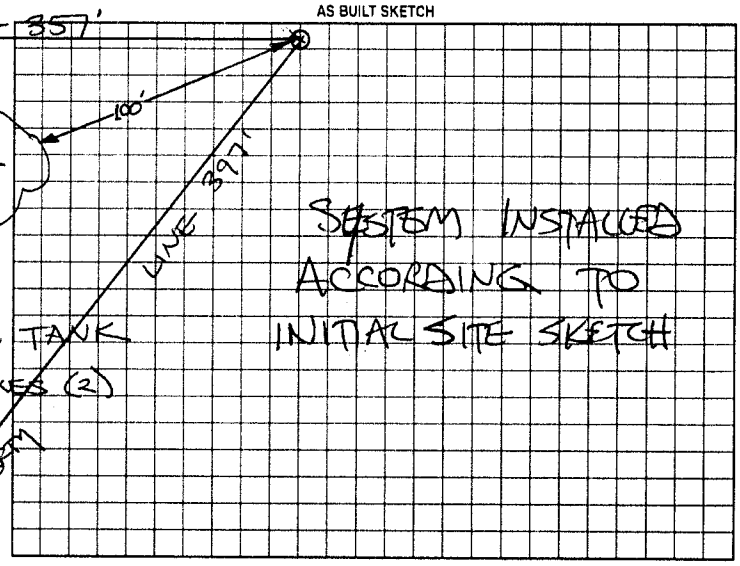

Permit can be suspended or revoked if any false information is supplied toward securing the permit/any unauthorized changes are made to the site/any unauthorized changes are made in the installation of the system. Improvement Permit with plat valid without expiration. Improvement Permit with site plan valid for sixty months. Authorization to Construct is valid for a period equal to that of Improvement Permit - not to exceed sixty months.

Signed: Sherrie Lee Jamison date 10-13-99

Improvement Permit by: STEVE HEDRICK date 10-12-99

Authorization to Construct by: STEVE HEDRICK date 10-12-99

Installed by: A-1 BACKHOE

Operation Permit by: STEVE HEDRICK date 10-28-99

Existing System Inspection by: ____ date ____

HEALTH DEPT COPY WHITE OWNER COPY (FINAL) YELLOW OWNER COPY (INITIAL) PINK