IREDELL COUNTY HEALTH DEPARTMENT

STATESVILLE 704-878-5305 MOORESVILLE 704-664-5281

IMPROVEMENT PERMIT / AUTHORIZATION TO CONSTRUCT / OPERATION PERMIT / EXISTING SYSTEM INSPECTION

PERMIT# 079 223 PIN# 4863 51 7453 DATE 2-12-99

OWNER OR CONTRACTOR JOHN WHITE PHONE: Business Home 929-8107

ADDRESS 3399 TURNERSBURG HWY, STATESVILLE NC 28625

LOCATION I-77 N, JR NC 901, TL EAGLE MILLS RD TL NATURES WAY, AT END ON LEFT

SUBDIVISION CHESTNUT RIDGE BLOCK / SECTION III LOT 7 LOT AREA 1.27 ACRES SITE CLASS PS DESIGN FLOW 360 L.T.A.R. 0.30 GPD/FT2

Septic Tank: 1000 Gallons: STB 1012 Date 5-17-99
Pump Tank: Gallons: PT Date
Pump Make: Model Serial No
Nitrification Field: No Fields 1 Square Feet 1200 Linear Feet 400
No Lines FOUR Trench Width 36" Max Trench Bottom Depth 36"

New System Repair System Type: I II III IV V
System Description: CONVENTIONAL GRAVITY
Repair System Description CONV. PUMP
Maintenance Agreement Required Yes No
Gravel Depth 12"

House/Mod. Home No. Bedrooms 3
Mobile Home No. Bathrooms 2
Business No. Employees
Other
Slab Crawl Space Basement w/plumbing Basement w/o plumbing


Water Supply: Individual Public Community
WELL

Comments/Conditions KEEP SYSTEM MINIMUM 100 FEET FROM WELL


SCALE 1"=50'

Comments/Conditions

INITIAL SITE SKETCH

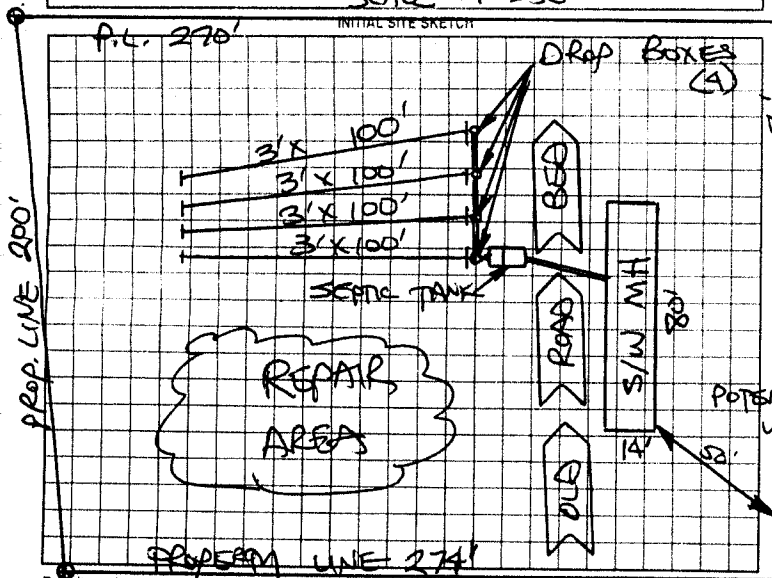

AS BUILT SKETCH

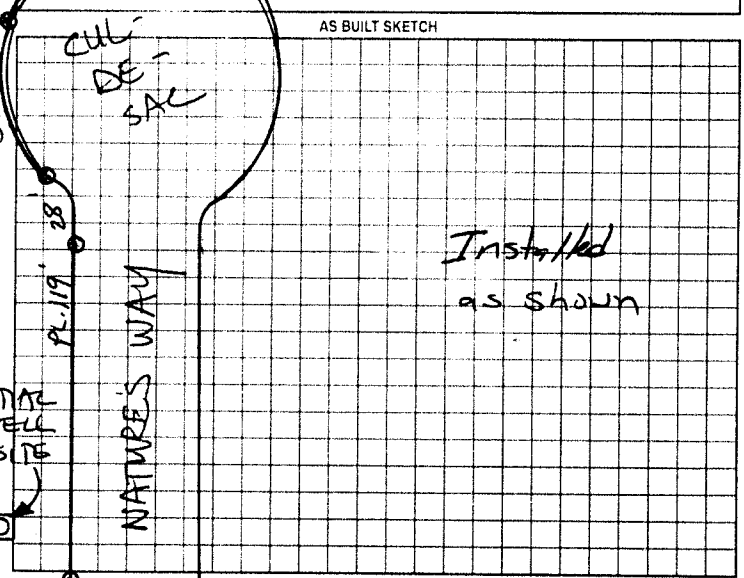

Permit can be suspended or revoked if any false information is supplied toward securing the permit, any unauthorized changes are made to the site, any unauthorized changes are made in the installation of the system. Improvement Permit with plat valid without expiration. Improvement Permit with site plan valid for sixty months. Authorization to Construct is valid for a period equal to that of Improvement Permit - not to exceed sixty months.

Signed: [signature] date 2-15-99

Improvement Permit by: STEVE HENDRICK date 2-12-99

Authorization to Construct by: STEVE HENDRICK date 2-12-99

Installed by: A-1 Backhoe

Operation Permit by: Mark C. Ortes date 7-22-99

Existing System Inspection by: date

HEALTH DEPT COPY WHITE OWNER COPY (FINAL) YELLOW OWNER COPY (INITIAL) PINK