IREDELL COUNTY HEALTH DEPARTMENT

STATESVILLE 704-878-5305 MOORESVILLE 704-664-5281

IMPROVEMENT PERMIT / AUTHORIZATION TO CONSTRUCT / OPERATION PERMIT / EXISTING SYSTEM INSPECTION

PERMIT# 078001 PIN# 4863 50 2713 (PART) DATE 3-15-99

OWNER OR CONTRACTOR AMERICAN LAND PHONE: Business 878-9595 Home

ADDRESS 128 GARNER BAGNAL BLVD, STATESVILLE, NC 28677

LOCATION I-77 N, TR NC901, TL EAGLE MILLS, TL NATURES WAY, AT END ON RIGHT

SUBDIVISION CHESHIRE RIDGE BLOCK / SECTION III LOT 4 LOT AREA 0.97 ACRE SITE CLASS PS DESIGN FLOW 360 L.T.A.R. 0.30 GPD/FT²

Septic Tank: 1000 Gallons; STB 1012 Date 3-13-99
Pump Tank: 1000 Gallons; PT 17 Date 3-28-99
Pump Make: HYDROMATIC Model SK50A1 Serial No.
Nitrification Field: No Fields Square Feet 600 TO 1200 Linear Feet 300
No Lines FIVE Trench Width 36" Max Trench Bottom Depth 20"

☑ New System ☐ Repair System Type: I. II. (III) IV. V. VI
System Description: 2012 HORIZONTAL SPS, HDS PUMP
Repair System Description: 2012 HOR. SPS, HDS PUMP
Maintenance Agreement Required: ☐ Yes ☑ No

☐ House/Mod. Home No. Bedrooms 3
☑ Mobile Home No. Bathrooms 2
☐ Business No. Employees
☐ Other


Water Supply: ☑ Individual ☐ Public ☐ Community WELL

Gravel Depth 12" HDS ☐ Slab ☑ Crawl Space ☐ Basement w/plumbing ☐ Basement wo/plumbing


Comments/Conditions: ① KEEP SYSTEM MINIMUM 100 FEET FROM WELL ② INSTALL THIRTY (30) HDS SECTIONS IN FIVE EQUAL LENGTH LINES ON CONTOUR NO DEEPER THAN 20" ③ SEE ATTACHED SHEETS FOR PUMP; PRESSURE MANIFOLD REQUIREMENTS

Comments/Conditions: 5/12 set pressure head no

INITIAL SITE SKETCH

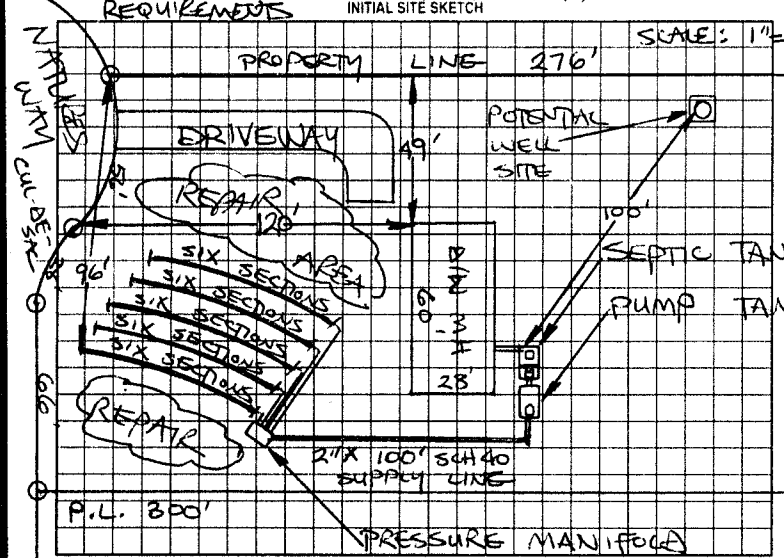

AS BUILT SKETCH

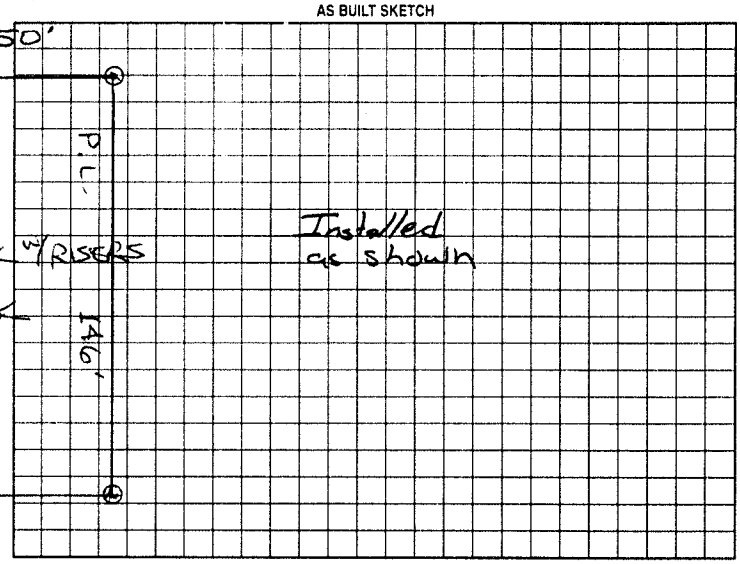

Permit can be suspended or revoked if any false information is supplied toward securing the permit/any unauthorized changes are made to the site/any unauthorized changes are made in the installation of the system. Improvement Permit with plat valid without expiration. Improvement Permit with site plan valid for sixty months. Authorization to Construct is valid for a period equal to that of Improvement Permit – not to exceed sixty months.

Signed: Sheree Seagroves date 3-17-99 Installed by: A-1 Backhoe

Improvement Permit by: STEVE HEDRICK date 3-15-99 Operation Permit by: Mary C Orf RS date 7-13-99

Authorization to Construct by: STEVE HEDRICK date 3-15-99 Existing System Inspection by: date

HEALTH DEPT COPY: WHITE OWNER COPY (FINAL) YELLOW OWNER COPY (INITIAL) PINK