THIS PERMIT VOIDS PREVIOUS ISSUED 9-29-99

IREDELL COUNTY HEALTH DEPARTMENT

STATESVILLE 704-878-5305 MOORESVILLE 704-664-5281

IMPROVEMENT PERMIT / AUTHORIZATION TO CONSTRUCT / OPERATION PERMIT / EXISTING SYSTEM INSPECTION

PERMIT# 083873 PIN# 4863 51 9687 DATE 10-12-99

OWNER OR CONTRACTOR DANIEL C. SIZEMORE PHONE: Business Home (704) 662-6110

ADDRESS 128 ACCENT LOOP, MOORESVILLE, NC 28115

LOCATION I-77N, TR NC 901, TL EAGLES MILL RD, TL NATURE'S WAY DR, 3RD LOT ON RIGHT

SUBDIVISION CHESHIRE RIDGE BLOCK / SECTION III LOT 3 LOT AREA 1.01 ACRE SITE CLASS PS DESIGN FLOW 360 L.T.A.R. 0.30 GPD/FT²

Septic Tank: 1000 Gallons; STB 1012 Date 8-7-99
Pump Tank: ____ Gallons; PT ____ Date ____
Pump Make: ____ Model ____ Serial No. ____
Nitrification Field: No Fields 1 Square Feet 1200 Linear Feet 400
No Lines FOUR Trench Width 36" Max Trench Bottom Depth 28" Gravel Depth 12"

☑ New System ☐ Repair System Type: I (II) III, IV, V, VI
System Description: CONVENTIONAL GRAVITY
Repair System Description: 25% REDUCTION GRAVITY
Maintenance Agreement Required: ☐ Yes ☑ No


☐ House/Mod. Home No. Bedrooms 3
☑ Mobile Home T/W No. Bathrooms 2
☐ Business No. Employees ____
☐ Other ____
☐ Slab ☑ Crawl Space ☐ Basement w/plumbing ☐ Basement wo/plumbing

Water Supply: ~~Individual~~ ☐ Public ☐ Community WELL


Comments/Conditions: ① INSTALL LINES ON CONTOUR AS FLAGGED NO DEEPER THAN 28"
② KEEP SYSTEM MINIMUM 100 FEET FROM WELL

Comments/Conditions: SEPTIC TANK WITH MARKER INSTALLED USING "POLYLOK" FILTER

SCALE: 1" = 50' INITIAL SITE SKETCH

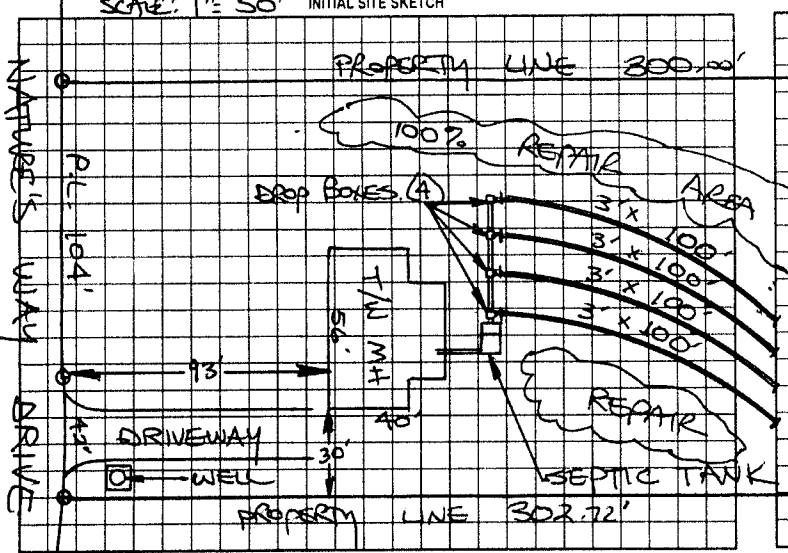

AS BUILT SKETCH

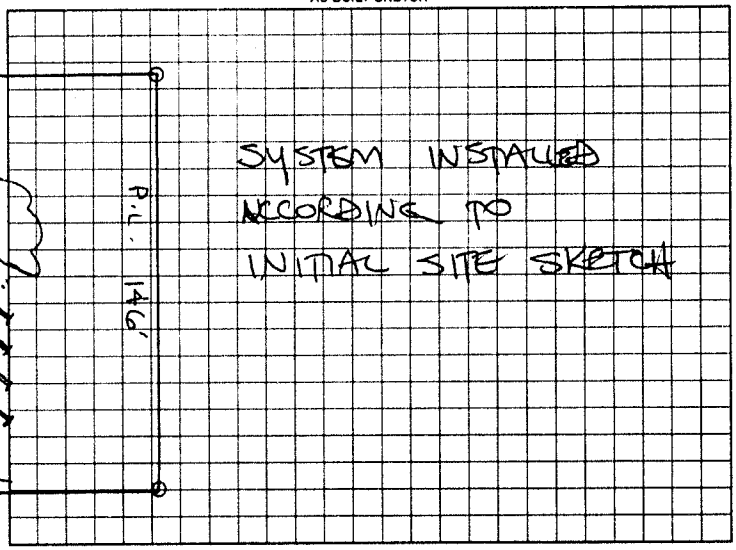

Permit can be suspended or revoked if any false information is supplied toward securing the permit/any unauthorized changes are made to the site/any unauthorized changes are made in the installation of the system. Improvement Permit with plat valid without expiration. Improvement Permit with site plan valid for sixty months. Authorization to Construct is valid for a period equal to that of Improvement Permit – not to exceed sixty months.

Signed: [signature] date 10-12-99 Installed by: A-1 BACKHOE

Improvement Permit by: STEVE HEDRICK date 10-12-99 Operation Permit by: STEVE HEDRICK date 10-18-99

Authorization to Construct by: STEVE HEDRICK date 10-12-99 Existing System Inspection by: ____ date ____

HEALTH DEPT. COPY: WHITE OWNER COPY (FINAL) YELLOW OWNER COPY (INITIAL) PINK