IREDELL COUNTY HEALTH DEPARTMENT

STATESVILLE 704-878-5305 MOORESVILLE 704-664-5281

IMPROVEMENT PERMIT / AUTHORIZATION TO CONSTRUCT / OPERATION PERMIT / EXISTING SYSTEM INSPECTION

PERMIT# REPAIR PIN# 4863-56-2648 DATE 2-12-03

OWNER OR CONTRACTOR SANDRA H. SHAVER PHONE: Business Home 704-539-4613

ADDRESS 223 HOLCOMB ROAD, HAMPTONVILLE, NC 27020-7274

LOCATION I-77 N, TR NC 901, TL EAGLE MILLS ROAD, TL HOLCOMB ROAD, HOUSE ON LEFT AT BOX #223

SUBDIVISION BLOCK / SECTION LOT LOT AREA 1 ACRE SITE CLASS PS DESIGN FLOW 360 L.T.A.R. EXISTING

Septic Tank: 1000 Gallons; STB 760 Date NO DATE

Pump Tank: Gallons; PT Date

Pump Make: Model Serial No.

Nitrification Field: No Fields 1 Square Feet 600 Linear Feet 200

No Lines THREE Trench Width 36" Max Trench Bottom Depth Gravel Depth 18"

☐ New System ☑ Repair System Type: I, (II), III, IV, V, VI

System Description:

Repair System Description: CONVENTIONAL, GRAVITY

Maintenance Agreement Required: ☐ Yes ☑ No

☑ House/Mod. Home No. Bedrooms 3

☐ Mobile Home No. Bathrooms 1

☐ Business No. Employees

☐ Other


☐ Slab ☑ Crawl Space ☐ Basement w/plumbing ☐ Basement wo/plumbing

Water Supply: ☑ Individual ☐ Public ☐ Community WELL


Comments/Conditions: ① STUB-OUT NEW PLUMBING AS HIGH IN ELEVATION AS POSSIBLE TO NEW SEPTIC TANK ② INSTALL LINES ON CONTOUR, AS SHALLOW AS POSSIBLE, USING 18 INCHES STONE

Comments/Conditions: SEPTIC TANK WITH MARKER INSTALLED USING "ZABEL" RISER

INITIAL SITE SKETCH

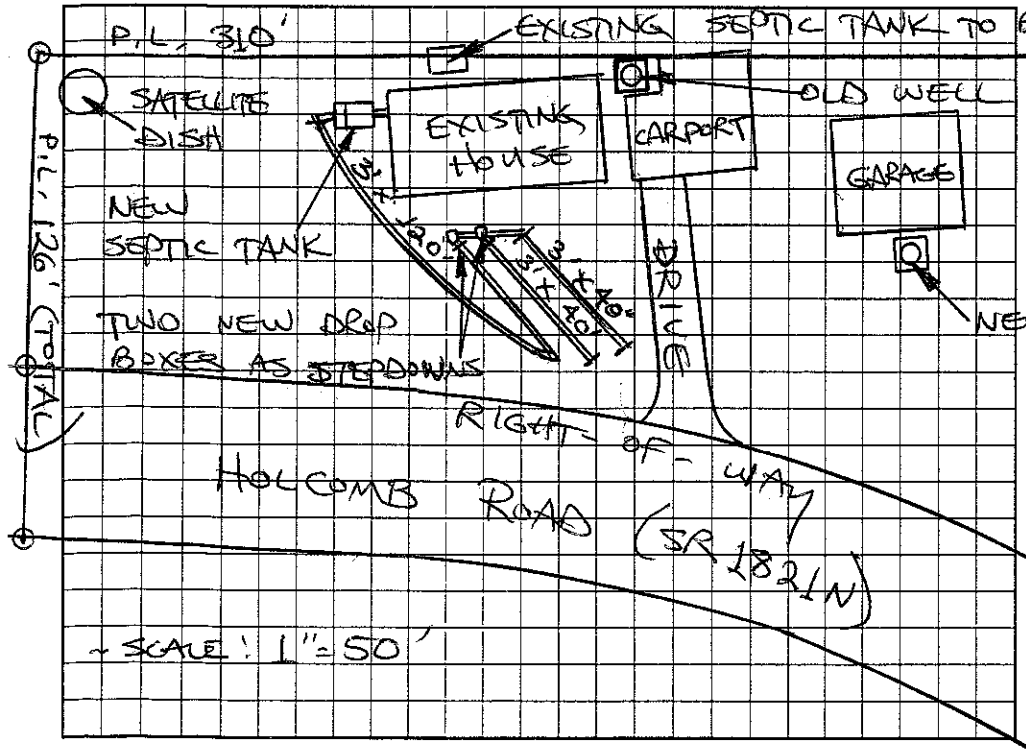

AS BUILT SKETCH

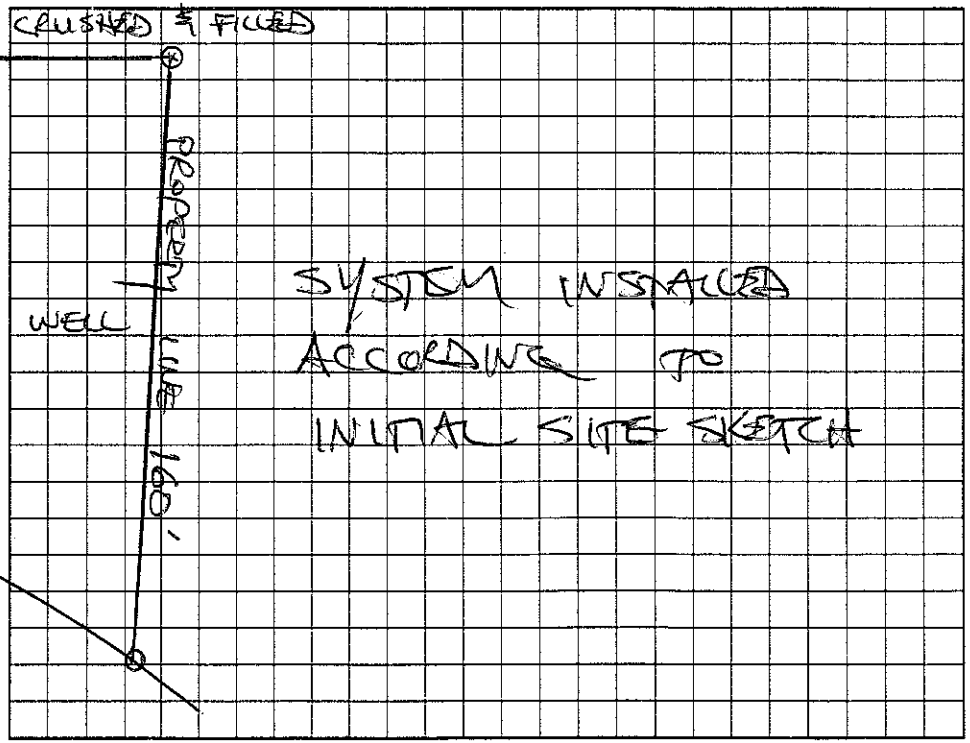

Permit can be suspended or revoked if any false information is supplied toward securing the permit/any unauthorized changes are made to the site/any unauthorized changes are made in the installation of the system. Improvement Permit with plat valid without expiration. Improvement Permit with site plan valid for sixty months. Authorization to Construct is valid for a period equal to that of Improvement Permit – not to exceed sixty months.

Signed: Sandra Shaver date 2-12-03 Installed by: BILLY GRIMES

Improvement Permit by: STEVE HEDRICK date 2-12-03 Operation Permit by: STEVE HEDRICK date 3-11-03

Authorization to Construct by: STEVE HEDRICK date 2-12-03 Existing System Inspection by: date

HEALTH DEPT. COPY: WHITE OWNER COPY (FINAL): YELLOW OWNER COPY (INITIAL): PINK