IREDELL COUNTY HEALTH DEPARTMENT

STATESVILLE 704-878-5305 MOORESVILLE 704-664-5281

IMPROVEMENT PERMIT / CERTIFICATE OF COMPLETION / OPERATION PERMIT / EXISTING SYSTEM INSPECTION

PROPERTY DESCRIPTION NO. 16922 DATE 9/1/93 TAX MAP NO. 17M-A-12A

OWNER OR CONTRACTOR HENRY C. NICHOLSON, JR PHONE: Business Home 539-4461

ADDRESS RT. 1, BOX 768, HAMPTONVILLE NC 27020

LOCATION I-77N, TR NC 901 E, TL EAGLE MILL RD, TL HOLCOMB RD ON (R) ~ 500'

SUBDIVISION HENRY C. NICHOLSON BLOCK / SECTION LOT 1 LOT AREA 130 x 175 SITE CLASS. PS L.T.A.R. 0.4 GPD/FT2

Water Supply: ☑ Individual ☐ Community ☐ Public SPRING

Septic Tank: 1000 Gallons; STB 782 Date 7/9/93

Pump Tank: ____ Gallons; PT ____ Date ____

Nitrification Field: No Fields 1 Square Feet 900 Linear Feet 300

No Lines 3 Trench Width 36" Trench Depth 18-36" Gravel Depth 12

☑ New System ☐ Repair System Type: I, II, III, IV, V, VI

System Description: CONV. GRAVITY

Repair System Description: CONV. GRAVITY

Maintenance Agreement Required: ☐ Yes ☑ No

☐ House/Mod. Home ☑ Mobile Home ☐ Business ☐ Other PLANNED FOR FUTURE 3BR

No. Bedrooms 2 No. Bathrooms 2 No. Employees ____

Garbage Disposal: ☐ Yes ☑ No

Auto. Dishwasher: ☐ Yes ☐ No


Auto. Washing Machine: ☑ Yes ☐ No

Other ____

☐ Slab ☑ Crawl Space ☐ Basement w/plumbing ☐ Basement wo/plumbing

Comments ____

INITIAL SITE SKETCH

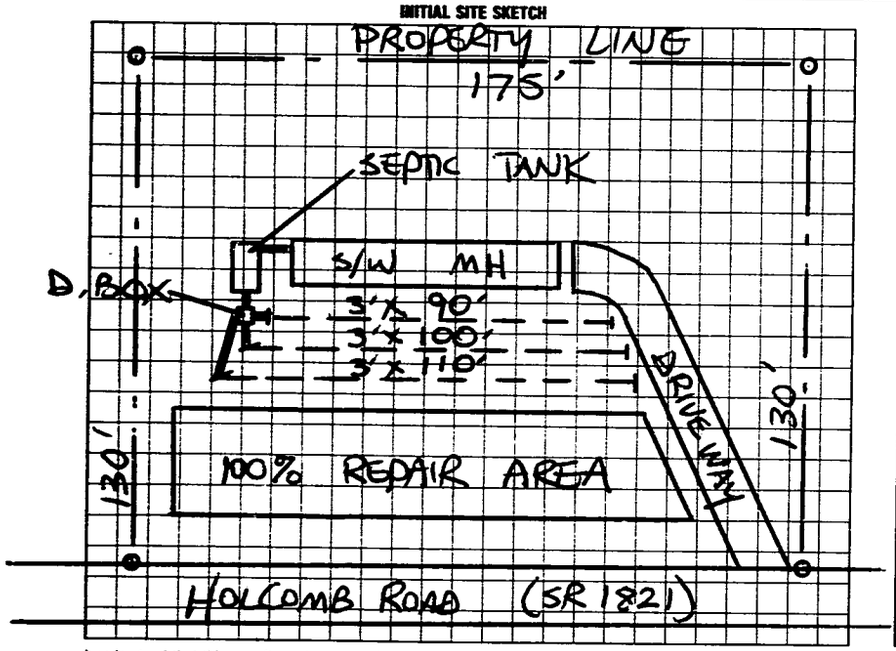

AS BUILT SKETCH

SYSTEM INSTALLED ACCORDING TO INITIAL SITE SKETCH

I understand that this permit can be suspended or revoked if any false information is supplied toward securing the permit/any unauthorized changes are made to the site/any unauthorized changes are made in the installation of the system. Improvement Permit is valid for 60 months from date of issuance.

Signed: X H.C. Nicholson

Improvement Permit by: STEVE HEDRICK date 9/1/93

Existing System Inspection by: ____ date ____

Installed by: A-1 BACKHOE

Certificate of Completion by: STEVE HEDRICK date 9/3/93

Operation Permit by: ____ date ____

HEALTH DEPT. COPY: WHITE INSPECTION COPY (FINAL): GREEN OWNER COPY (FINAL): YELLOW INSPECTION COPY (INITIAL): PINK OWNER COPY (INITIAL): GOLD