IREDELL COUNTY HEALTH DEPARTMENT

STATESVILLE 704-878-5305 MOORESVILLE 704-664-5281

IMPROVEMENT PERMIT / AUTHORIZATION TO CONSTRUCT / OPERATION PERMIT / EXISTING SYSTEM INSPECTION

PERMIT# 133450 PIN# 4863777202028 565469 DATE 1-26-06

OWNER OR CONTRACTOR Henery Nicholson PHONE: Business _____ Home 704-539-4461

ADDRESS 205 Holcomb RD Hamptonville NC 27020

LOCATION I77 N to 65 (R) Mulles Rd (R) Manz (L) Lurette (R) Holcomb 1st lot Past Leeland

SUBDIVISION ~~Davis Acres~~ Holcomb BLOCK / SECTION _____ LOT _____ LOT AREA .52 SITE CLASS R5 DESIGN FLOW 240 L.T.A.R. .4

Septic Tank: 1000 Gallons; STB _____ Date _____

Pump Tank: _____ Gallons; PT _____ Date _____

Pump Make: _____ Model _____ Serial No. _____

Nitrification Field: No Fields ___ Square Feet 900 Linear Feet 300

No Lines 12 Trench Width 36" Max Trench Bottom Depth 36" Gravel Depth 12

☐ New System ☐ Repair System Type: (I) II III IV V VI

System Description: Exist – Cover Correct

Repair System Description: _____

Maintenance Agreement Required: ☐ Yes ☐ No

☐ House/Mod. Home No. Bedrooms 2

☑ Mobile Home No. Bathrooms ___

☐ Business No. Employees ___

☐ Other _____

☐ Slab ☑ Crawl Space ☐ Basement w/plumbing ☐ Basement wo/plumbing

Water Supply: ☐ Individual ☐ Public ☐ Community

Comments:/Conditions:


Comments:/Conditions:

Can also be 3 bdr

Is designed for 3BDR

INITIAL SITE SKETCH

AS BUILT SKETCH

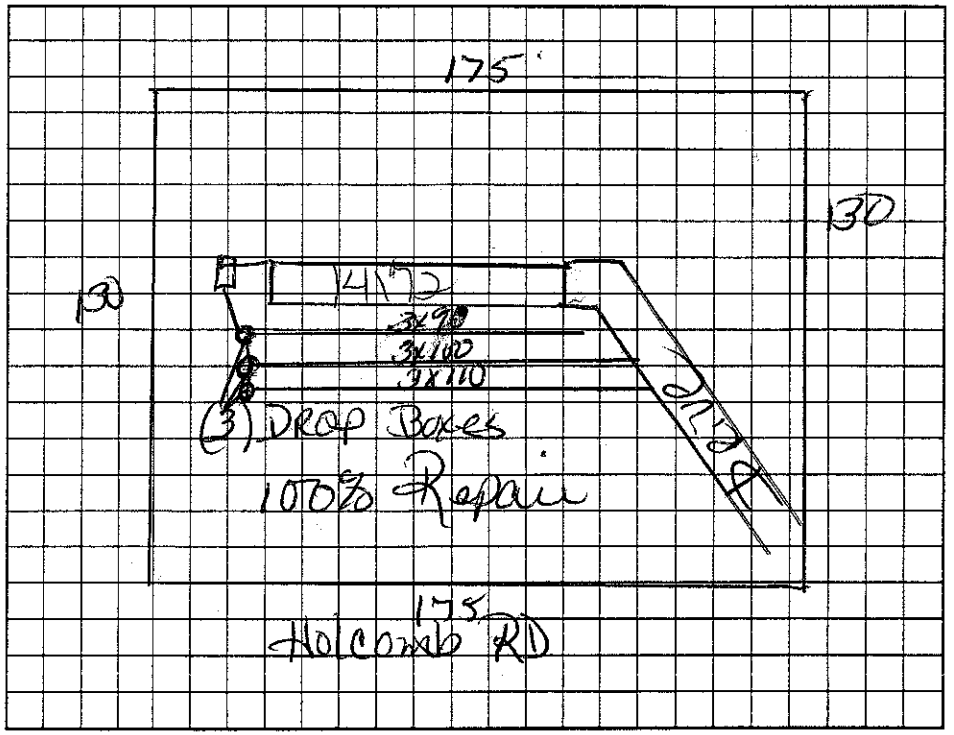

Permit can be suspended or revoked if any false information is supplied toward securing the permit/any unauthorized changes are made to the site/any unauthorized changes are made in the installation of the system. Improvement Permit with plat valid without expiration. Improvement Permit with site plan valid for sixty months. Authorization to Construct is valid for a period equal to that of Improvement Permit – not to exceed sixty months.

Signed: H.C. Nicholson date 1-26-06 Installed by: _____

Improvement Permit by: _____ date _____ Operation Permit by: _____ date /

Authorization to Construct by: _____ date _____ Existing System Inspection by: Kelly Cox date 1-26-06

HEALTH DEPT. COPY: WHITE OWNER COPY (FINAL): YELLOW OWNER COPY (INITIAL): PINK