IREDELL COUNTY HEALTH DEPARTMENT

STATESVILLE 704-878-5305 MOORESVILLE 704-664-5281

IMPROVEMENT PERMIT / AUTHORIZATION TO CONSTRUCT / OPERATION PERMIT / EXISTING SYSTEM INSPECTION

PERMIT# 077495 PIN# 4863 59 7859 DATE 11-20-98

OWNER OR CONTRACTOR I. H. WALLACE PHONE: Business Home 539-4962

ADDRESS 655 TRIVETTE RD, UNION GROVE, NC 28689

LOCATION NC 901, TL EAGLE MILLS ROAD, DN Right 4TH MH PAST OLD WESLEY ROAD,

SUBDIVISION BLOCK / SECTION LOT LOT AREA 20.70 ACRES SITE CLASS PS DESIGN FLOW 360 L.T.A.R. 0.30 GPD/FT²

Septic Tank 1000 Gallons: STB 1012 Date 9-17-98

Pump Tank Gallons: PT Date

Pump Make Model

No. Lines FIVE Trench Width 36" Max. Trench Bottom Depth 36" Gravel Depth 12"

✓ New System Repair System Type I II III IV V VI

System Description CONVENTIONAL GRAVITY CONV. GRAVITY

Maintenance Agreement Required yes ✓ No

✓ House/Mod. Home No. Bedrooms 2

✓ Mobile Home No. Bathrooms 2

Other


Slab ✓ Crawl Space Basement w/plumbing Basement wo/plumbing

Water Supply: ☐ Individual ☐ Public ✓ Community WELL NEXT DOOR

Comments/Conditions:

Comments/Conditions

INITIAL SITE SKETCH SCALE: 1"=40'

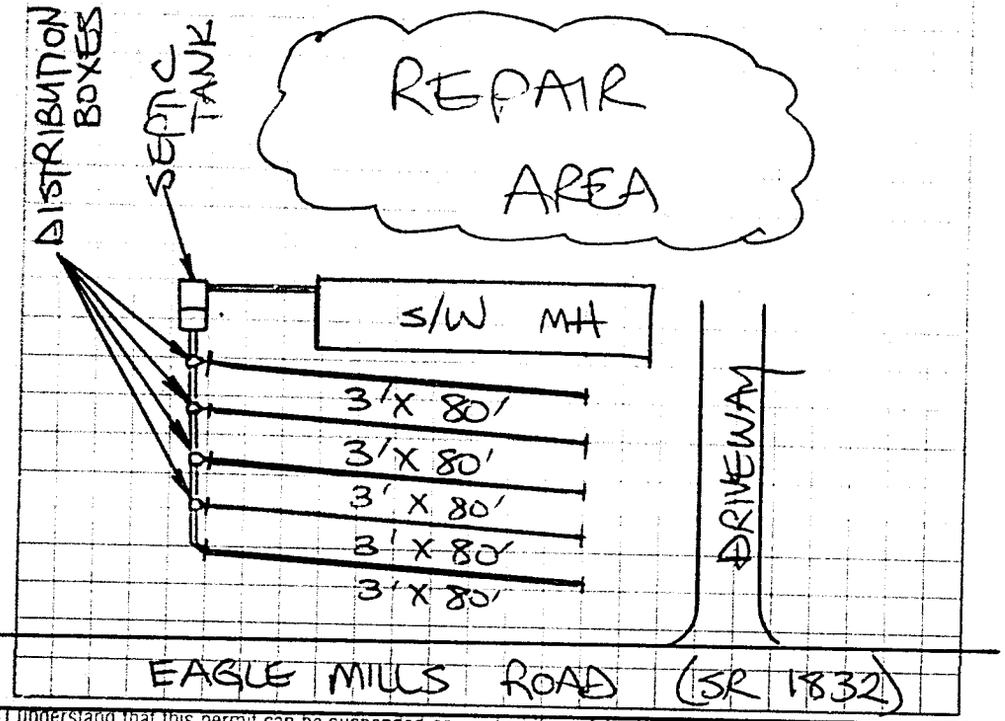

AS BUILT SKETCH

SYSTEM INSTALLED ACCORDING TO INITAL SITE SKETCH

I understand that this permit can be suspended or revoked if any false information is supplied toward securing the permit/any unauthorized changes are made to the site/any unauthorized changes are made in the installation of the system. Improvement Permit with plat valid without expiration. Improvement Permit with site plan valid for sixty months. Authorization to Construct is valid for a period equal to that of Improvement Permit – not to exceed sixty months.

Signed: + T. H. Wallace date 11-20-98 Installed by: Tommy Frye

Improvement Permit by: STEVE HEDRICK date 11-20-98 Operation Permit by: STEVE HEDRICK date 11-30-98

Authorization to Construct by: STEVE HEDRICK date 11-20-98 Existing System Inspection by: date

HEALTH DEPT COPY WHITE INSPECTION COPY (FINAL) GREEN OWNER COPY (FINAL) YELLOW INSPECTION COPY (INITIAL) PINK OWNER COPY