IREDELL COUNTY HEALTH DEPARTMENT

STATESVILLE 704-878-5305 MOORESVILLE 704-664-5281

IMPROVEMENT PERMIT / AUTHORIZATION TO CONSTRUCT / OPERATION PERMIT / EXISTING SYSTEM INSPECTION

PERMIT# 077485 PIN# 4862 28 8814 DATE 11-3-98

OWNER OR CONTRACTOR WALTER STRANG PHONE: Business Home

ADDRESS 158 DOGWOOD EST STATESVILLE, NC 28677

LOCATION I-77 N, TR NC 901, TL EAGLE MILLS RD, TL NATURES WAY TL SCENIC POINT, 2ND ON (L)

SUBDIVISION CHESHIRE RIDGE BLOCK / SECTION III LOT 13 LOT AREA 10.77 ACRE SITE CLASS. PS DESIGN FLOW 360 L.T.A.R. 0.30 GPD/FT²

Septic Tank: 1000 Gallons; STB 794 Date 9-9-98
Pump Tank: Gallons; PT Date
Pump Make: Model Serial No.
Nitrification Field: No Fields 1 Square Feet EQ. TO 1200 Linear Feet 300±
No Lines FOUR Trench Width 36" Max Trench Bottom Depth 36" Gravel Depth SAND 6"

✓ New System ☐ Repair System Type: I, II, (III), IV, V, VI
System Description: 25% REDUCTION GRAVITY
Repair System Description: PPBPS - GRAVITY
Maintenance Agreement Required: ☐ Yes ✓ No

☐ House/Mod. Home ✓ Mobile Home ☐ Business ☐ Other
No. Bedrooms 3 No. Bathrooms 2 No. Employees


☐ Slab ☐ Crawl Space ☐ Basement w/plumbing ☐ Basement wo/plumbing

Water Supply: ✓ Individual ☐ Public ☐ Community WELL

Comments:/Conditions: ① INSTALL FORTY-EIGHT 6' CHAMBERS OR THIRTY H.D.S. SECTIONS FOR 25% REDUCTION
② KEEP SYSTEM MINIMUM 100' FROM WELL

Comments:/Conditions:

INITIAL SITE SKETCH SCALE: 1"=40'

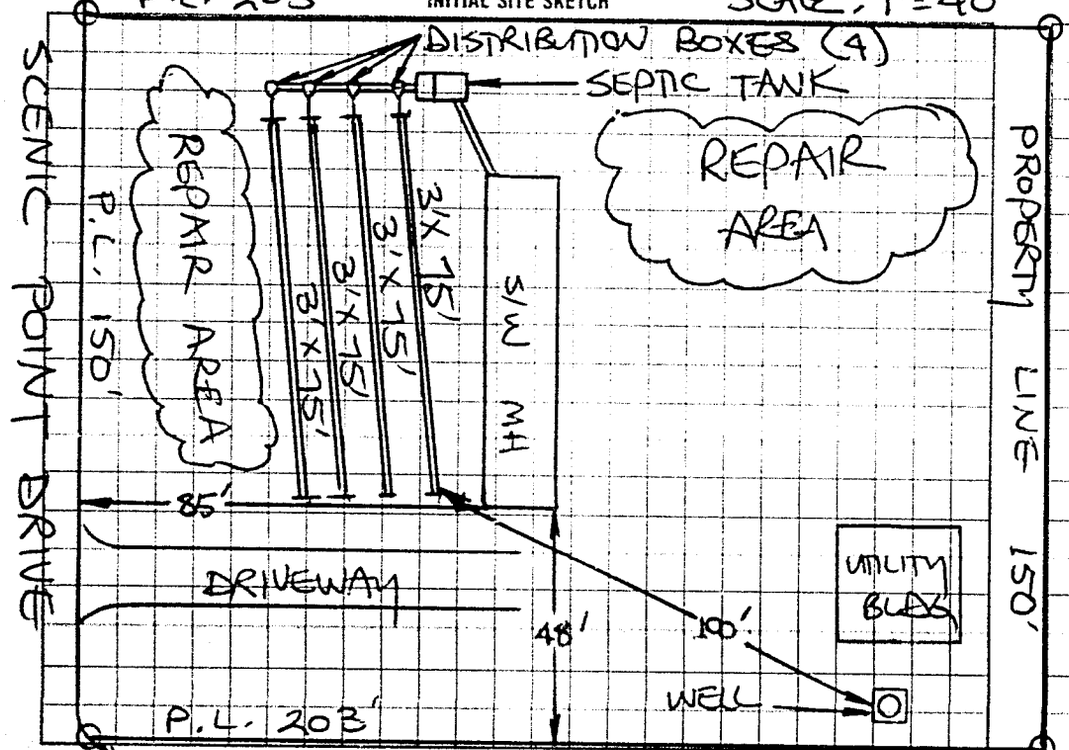

AS BUILT SKETCH

SYSTEM INSTALLED ACCORDING TO INITIAL SITE SKETCH

I understand that this permit can be suspended or revoked if any false information is supplied toward securing the permit/any unauthorized changes are made to the site/any unauthorized changes are made in the installation of the system. Improvement Permit with plat valid without expiration. Improvement Permit with site plan valid for sixty months. Authorization to Construct is valid for a period equal to that of Improvement Permit – not to exceed sixty months.

Signed: Claudette Ballard date 11-5-98

Improvement Permit by: STEVE HEDRICK date 11-3-98

Authorization to Construct by: STEVE HEDRICK date 11-3-98

Installed by: JAMES HULER

Operation Permit by: STEVE HEDRICK date 11-23-98

Existing System Inspection by date

CUL-DE-SAC

HEALTH DEPT. COPY: WHITE INSPECTION COPY (FINAL): GREEN OWNER COPY (FINAL): YELLOW INSPECTION COPY (INITIAL): PINK OWNER COPY (INITIAL): GOLD

8 4 8 0 0