IREDELL COUNTY HEALTH DEPARTMENT

Statesville Office (704) 878-5305 Mooresville Office (704) 660-3625 PERMIT # 216639

IMPROVEMENT PERMIT / AUTHORIZATION TO CONSTRUCT / OPERATION PERMIT / EXISTING SYSTEM

PIN # 4863637627

APPLICANT: Jack West APPLICANT ADDRESS: 719 Eagle Mills Rd

SITE ADDRESS: 719 Eagle Mills Rd. PHONE: 919-730-2774 ALT. PHONE: 704-539-5339

SITE DIRECTIONS: Hwy 21 N TL Hwy 901 TR Eagle Mills Rd. House on left after crossing bridge

SUBDIVISION: N/A SECTION: N/A LOT # N/A LOT AREA: 3.92 acres DESIGN FLOW: 360 gpd L.T.A.R.: Existing

Septic Tank	Existing (gal)	STB		Date					
Pump Tank		(gal)	PT		Date				
Pump Make		Model		Serial #					
# Nitrification Fields	Ex	# Lines	Ex	Linear Ft:	Ex				
Trench Width	Ex	Max. Trench Bottom Depth	Ex	Gravel Depth	Ex				

☐ New System ☐ Repair ☐ Expansion System Type: I (II) III IV V VI

System Description: Existing

Repair System Description: 25% Reduction

Maintenance Agreement Required: ☐ YES ☑ NO

☑ GRAVITY ☐ PRESSURE

☑ Residence No. Bedrooms 3

☐ Business No. Persons 6

☐ Other No. Employees

☐ Slab ☑ Crawl Space


☐ Basement w/plumbing ☐ Basement w/o plumbing

Water Supply: ☑ Private ☐ Public ☐ Community


Comments / Conditions: -Remove existing mobile home from existing septic system prior to connecting proposed new home to existing septic system.

Maintain a minimum of 10' between home foundation & septic system.

INITIAL SITE SKETCH

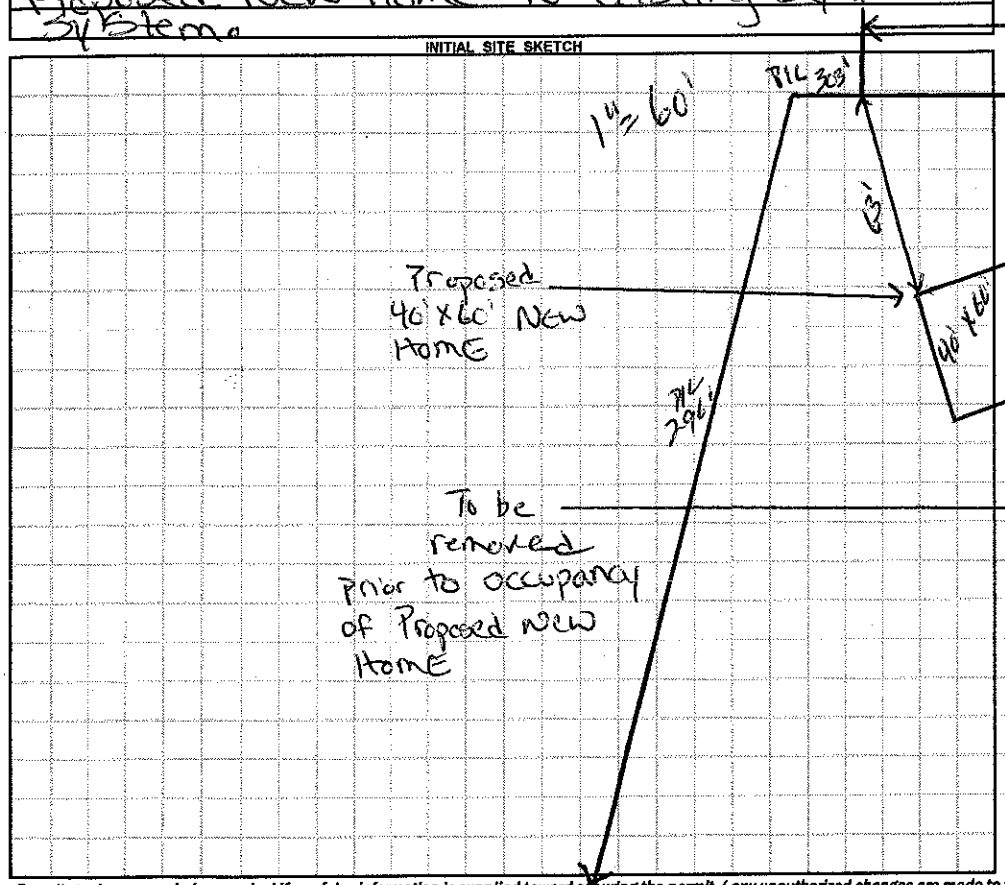

AS BUILT SKETCH

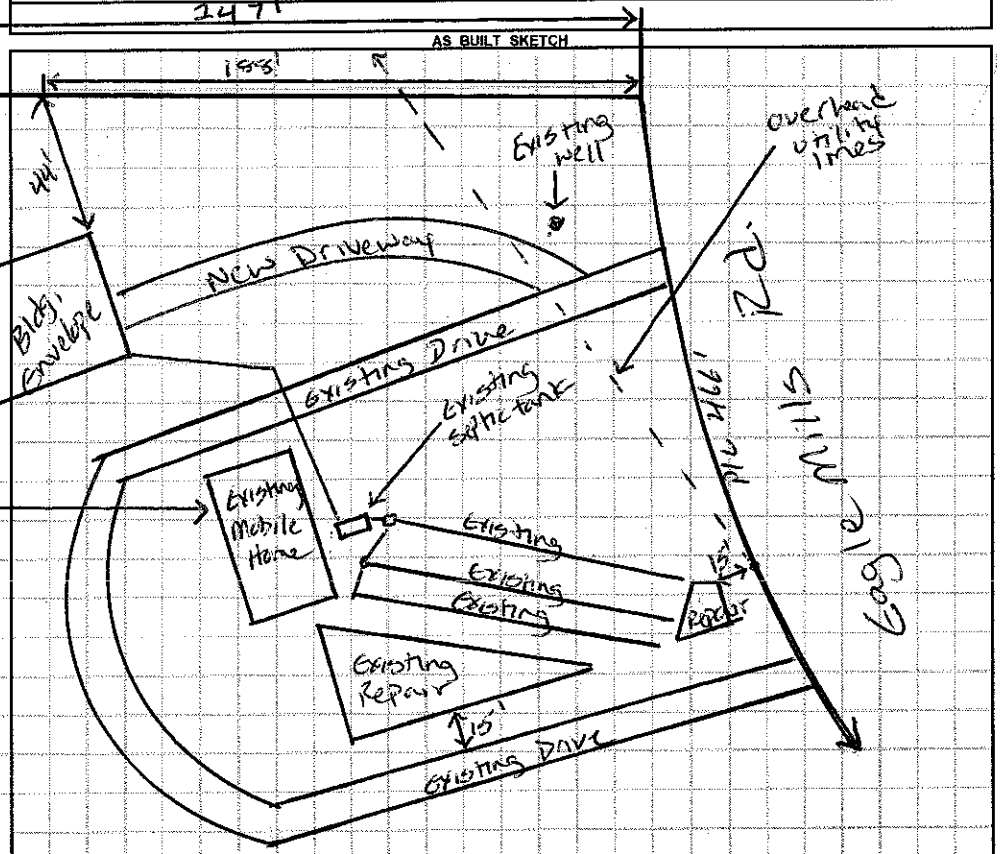

Permit can be suspended or revoked if any false information is supplied toward securing the permit / any unauthorized changes are made to the site / any unauthorized changes are made in the installation of the system. **CONTACT A LOCATOR SERVICE PRIOR TO ANY EXCAVATION**


☐ **IMPROVEMENT PERMIT** *with plat valid without expiration.* ☐ **IMPROVEMENT PERMIT** *with site plan valid for 60 mos.* ☐ **AUTHORIZATION TO CONSTRUCT** *valid for period equal to IMPROVEMENT PERMIT--not to exceed 60 mo.*

Owner / Applicant Signature: Jack West Date: 3/3/16 Installed by:

IMPROVEMENT PERMIT by: Date: OPERATION PERMIT by: Date:

AUTHORIZATION TO CONSTRUCT by: Date: Existing System Inspected by: Justin Henderson Date: 3-3-16

Health Dept. Copy - WHITE Applicant (Final Approval) - YELLOW Applicant (Conditional Approval) - PINK

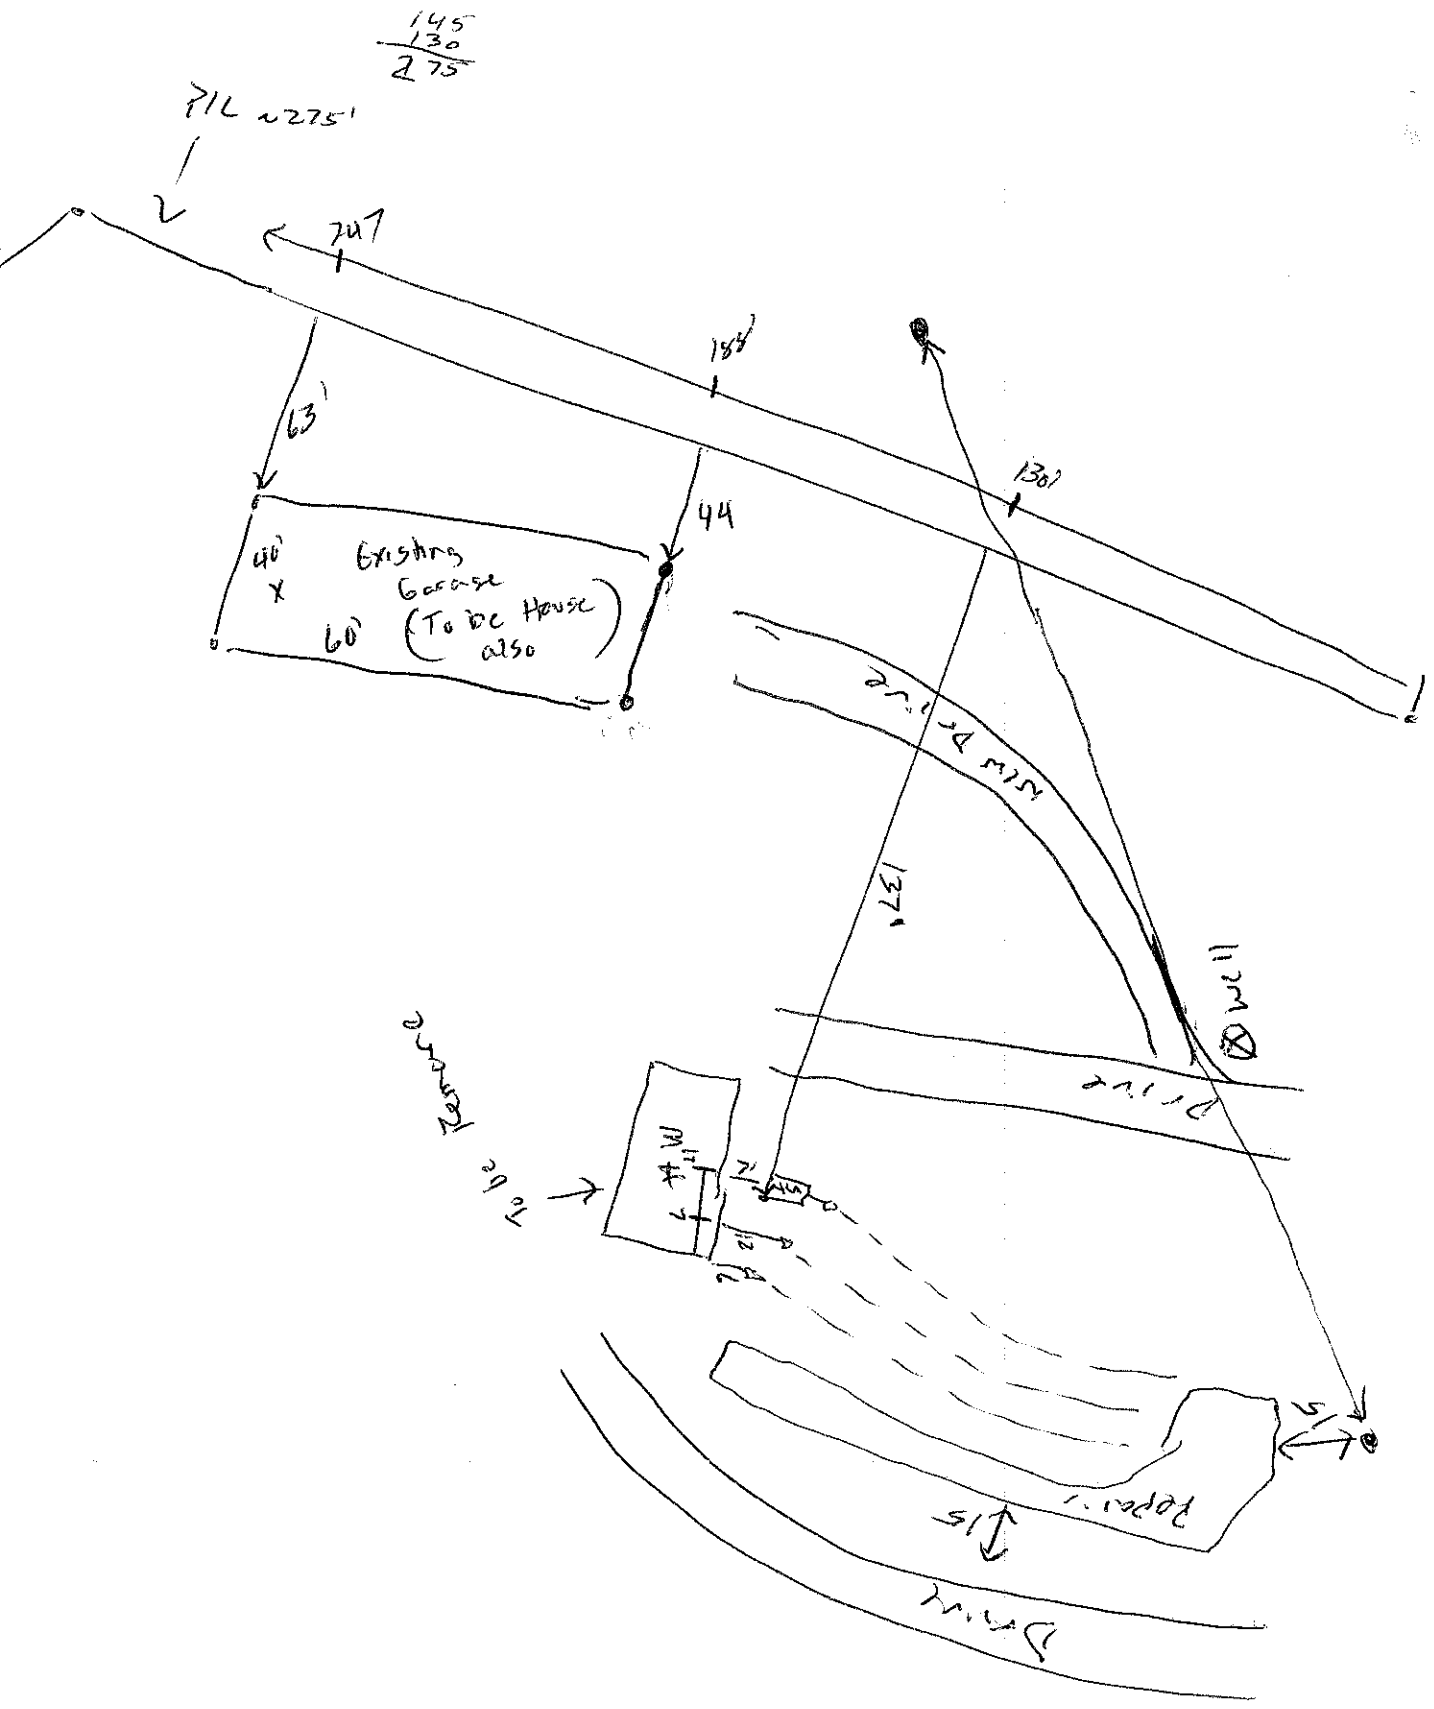
145
130
275
P/L ~275'
247
185'
63'
130'
44
40'
X
60'
Existing
Garage
(To be House
also
Well
127'
15'