Jack West

IREDELL COUNTY HEALTH DEPARTMENT

203398

6/6/16

STATESVILLE 704-878-5305 MOORESVILLE 704-664-5281

IMPROVEMENT PERMIT / CERTIFICATE OF COMPLETION / OPERATION PERMIT / EXISTING SYSTEM INSPECTION

PROPERTY DESCRIPTION NO. 236668 DATE 5-13-96 TAX MAP NO. 17M-A-96 (PART OF) Watershed ☐ Yes ☐ No

OWNER OR CONTRACTOR JAMES HEDGER PHONE: Business Home (910) 966-0294

ADDRESS 121 JEFFERSON STREET #2 KERNERSVILLE, NC 27284

LOCATION I-77 N, TR NC901, TL EAGLE MILLS RD, ON LEFT JUST PAST HUNTING CREEK BRIDGE

SUBDIVISION _____ BLOCK / SECTION _____ LOT _____ LOT AREA ACRES SITE CLASS. _____ DESIGN FLOW 360 L.T.A.R. 0.40 GRAFT 2

Septic Tank: 1000 Gallons; STB 1021 Date 4-30-96 ☑ New System ☐ Repair System Type: I II III IV V VI

Pump Tank: _____ Gallons; PT _____ Date _____

Pump Make: _____ Model _____ Serial No _____

Nitrification Field: No Fields 1 Square Feet 900 Linear Feet 300

No Lines 3 Trench Width 36" Max Trench Bottom Depth 18-36" Gravel Depth 12"

System Description: CONVENTIONAL, GRAVITY

Repair System Description: CONV. GRAVITY

Maintenance Agreement Required: ☐ Yes ☐ No

☐ House/Mod. Home ☑ Mobile Home ☐ Business ☐ Other

No. Bedrooms 3 No. Bathrooms 2 No. Employees ____


☐ Slab ☑ Crawl Space ☐ Basement w/plumbing ☐ Basement w/o plumbing

Water Supply: ☐ Individual ☐ Community ☐ Public WELL

Comments: ① KEEP SYSTEM MINIMUM 100' FROM WELL, 10' FROM PROPERTY LINE, 5' FROM MH ② INSTALL LINES ON CONTOUR NO DEEPER THAN 36" 9' MINIMUM APART O.C.

Comments: MH SITE ALTERED AS SHOWN

INITIAL SITE SKETCH

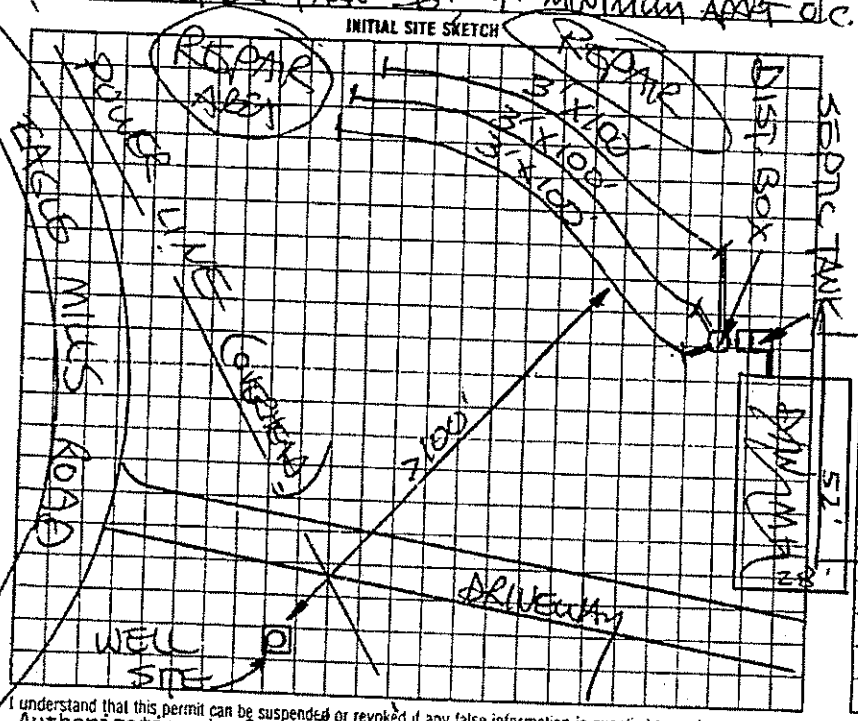


AS BUILT SKETCH

Location of the proposed 30'x18' garage addition does not appear to impact the existing on-site septic system or well.**NOTE:

Debra H Lamm REHS Date: 05/23/14

ICHD-Environmental Health Division

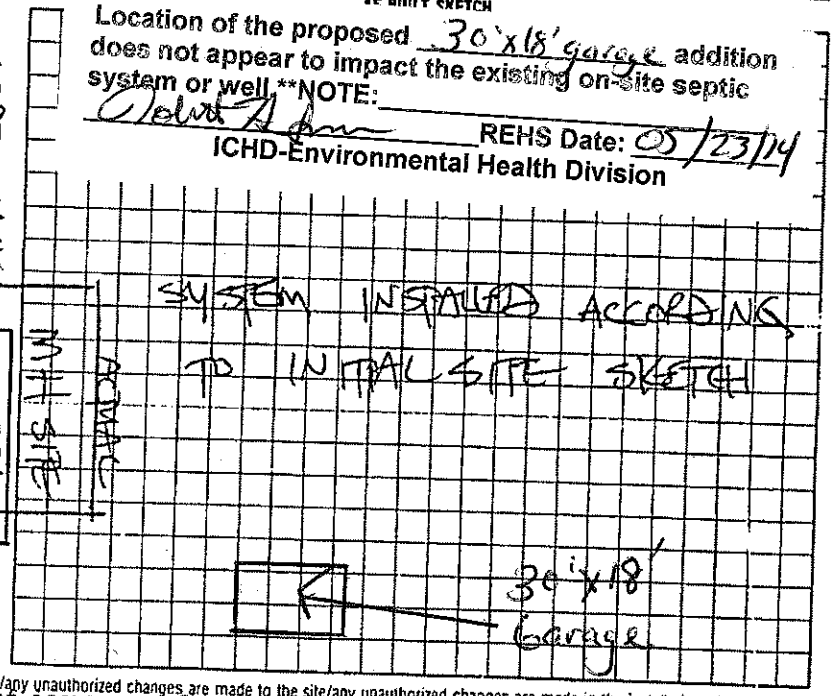

I understand that this permit can be suspended or revoked if any false information is supplied toward securing the permit/any unauthorized changes are made to the site/any unauthorized changes are made in the installation of the system. Authorization to Construct is valid five (5) years from date of issuance. Improvement Permit has no expiration date.

Signed: X James Hedger

Improvement Permit by: STEVE HEDRICK date 5-13-96

AUTHORIZATION TO CONSTRUCT: STEVE HEDRICK date 5-13-96

Installed by: TOMMY FLYE

Certificate of Completion by: _____ date _____

Operation Permit by STEVE HEDRICK date 7-26-96

HEALTH DEPT COPY WHITE | INSPECTION COPY (FINAL) GREEN | OWNER COPY (FINAL) YELLOW | INSPECTION COPY (INITIAL) PINK | OWNER COPY (INITIAL) GOLD

Σ 0 L 0 0 0