IREDELL COUNTY HEALTH DEPARTMENT

STATESVILLE 704-878-5305 MOORESVILLE 704-664-5281

IMPROVEMENT PERMIT / CERTIFICATE OF COMPLETION / OPERATION PERMIT / EXISTING SYSTEM INSPECTION

PROPERTY DESCRIPTION NO. REPAIR DATE 7-14-95 TAX MAP NO.

OWNER OR CONTRACTOR ABE HANDY JR PHONE: Business Home 539-4876

ADDRESS 567 EAGLE MILLS RD, HAMPTONVILLE 27020 Watershed: ☐ Yes ☐ No

LOCATION I-77 N, TR NC 901, TL EAGLE MILLS RD, LAST HOUSE ON (L) BEFORE EAGLE MILLS ASSEMBLY OF GOD CHURCH (ON RIGHT)

SUBDIVISION BLOCK / SECTION LOT LOT AREA AMPLE SITE CLASS. PS DESIGN FLOW 240 L.T.A.R. EXISTING

Septic Tank: EXISTING Gallons; STB Date

Pump Tank: Gallons; PT Date

Pump Make: Model Serial No.

Nitrification Field: No Fields | Square Feet 300 Linear Feet 100

No Lines | Trench Width 36" Max Trench Bottom Depth 36" Gravel Depth 24"

☐ New System ☑ Repair System Type: ☒ I, II ☐ III, IV, V, VI

System Description:

Repair System Description: CONV. GRAVITY

Maintenance Agreement Required: ☐ Yes ☑ No

☑ House/Mod. Home No. Bedrooms 2

☐ Mobile Home No. Bathrooms

☐ Business No. Employees

☐ Other


☐ Slab ☑ Crawl Space ☐ Basement w/plumbing ☐ Basement wo/plumbing

Water Supply: ☑ Individual ☐ Community ☐ Public WELL

Comments: (1) INSTALL NEW SANITARY TEE IN TANK (2) INSTALL NEW DISTRIBUTION BOX (3) INSTALL NEW 3'x100' LINE AS SHOWN USING 24" STONE

Comments:

INITIAL SITE SKETCH

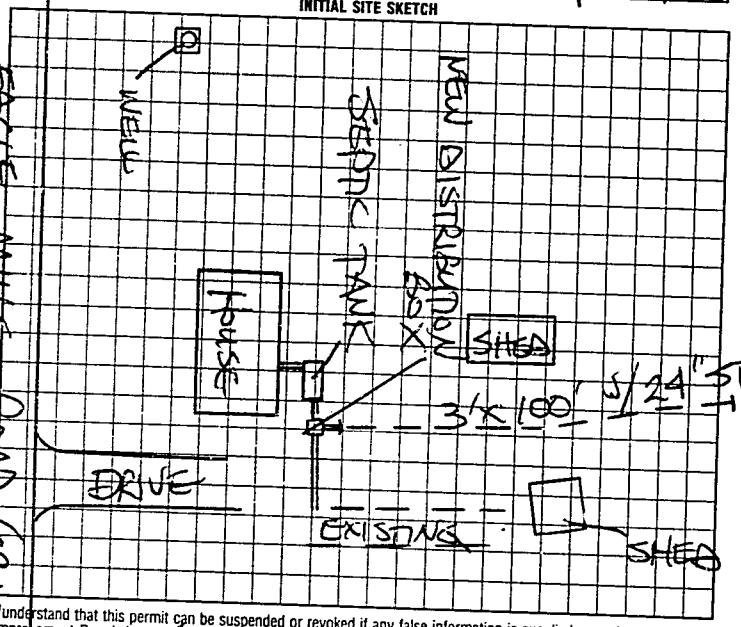

AS BUILT SKETCH

SYSTEM REPAIRED ACCORDING TO INITAL SITE SKETCH

I understand that this permit can be suspended or revoked if any false information is supplied toward securing the permit/any unauthorized changes are made to the site/any unauthorized changes are made in the installation of the system. Improvement Permit is valid for 60 months from date of issuance.

Signed: X

Improvement Permit by: STEVEN HEDRICK date 7-14-95

Existing System Inspection by: date

Installed by: TOMMY NIXON

Certificate of Completion by: STEVEN HEDRICK date 7-19-95

Operation Permit by: date

HEALTH DEPT. COPY: WHITE INSPECTION COPY (FINAL): GREEN OWNER COPY (FINAL): YELLOW INSPECTION COPY (INITIAL): PINK OWNER COPY (INITIAL): GOLD