IREDELL COUNTY HEALTH DEPARTMENT

STATESVILLE 704-878-5305 MOORESVILLE 704-664-5281

IMPROVEMENT PERMIT / CERTIFICATE OF COMPLETION / OPERATION PERMIT / EXISTING SYSTEM INSPECTION

PROPERTY DESCRIPTION NO. 25713 DATE 3-3-97 TAX MAP NO. MU-A-45/51 Watershed: ☒ Yes ☐ No

OWNER OR CONTRACTOR Eagle mills Assembly of God PHONE: Business 539-4876 Home WSIII Bow

ADDRESS 567 Eagle mills Rd Hamptonville, N.C. 27020

LOCATION I-77 N TR 901 TL Eagle mill Rd Past Yorkspun pt on rt

SUBDIVISION BLOCK / SECTION LOT LOT AREA 7.63 acres SITE CLASS DESIGN FLOW L.T.A.R.

Septic Tank: EX 1000 Gallons; STB Date

Pump Tank: Gallons; PT Date

Pump Make: Model Serial No.

Nitrification Field: No Fields 1 Square Feet 900 Linear Feet 300

No Lines 3 Trench Width 108" Max Trench Bottom Depth 36" Gravel Depth 12"

☐ New System ☐ Repair System Type: I, II, III, IV, V, VI

System Description:

Repair System Description:

Maintenance Agreement Required: ☐ Yes ☒ No

☐ Slab ☐ Crawl Space ☐ Basement w/plumbing ☒ Basement w/o plumbing

☐ House/Mod. Home No. Bedrooms

☐ Mobile Home No. Bathrooms

☐ Business No. Employees

☒ Other Athletic 32X60 Fellowship Hall

Water Supply: ☒ Individual ☐ Community ☐ Public


Comments:

Comments: 2 To Exi Church

722

INITIAL SITE SKETCH

AS BUILT SKETCH

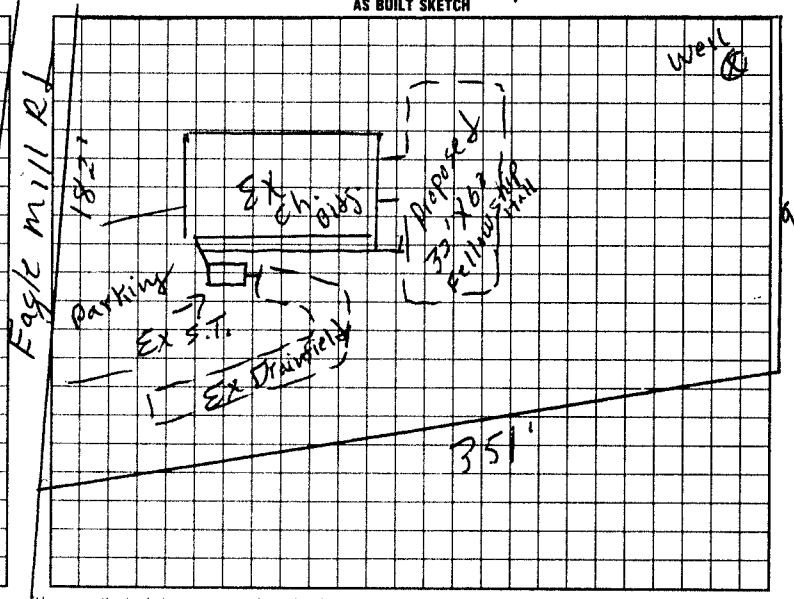

I understand that this permit can be suspended or revoked if any false information is supplied toward securing the permit/any unauthorized changes are made to the site/any unauthorized changes are made in the installation of the system. Improvement Permit is valid for 60 months from date of issuance.

Signed:

Improvement Permit by: date

Existing System Inspection by: R.C. Moore date 3-3-97

Installed by:

Certificate of Completion by: date

Operation Permit by: date

HEALTH DEPT. COPY: WHITE INSPECTION COPY (FINAL): GREEN OWNER COPY (FINAL): YELLOW INSPECTION COPY (INITIAL): PINK OWNER COPY (INITIAL): GOLD