IREDELL COUNTY HEALTH DEPARTMENT

Statesville Phone TR 3-7271 Mooresville Phone NO 3-1271

PERMIT TO INSTALL SEPTIC TANK

Permit NO._____ Permit Date 9-10 1963

Owner WINA HEPLER Address RT 1 HAMPTONVILLE

Installed By GLENN J. TALLEY Address YADKINVILLE N.C.


Location of Property_____

| Tank | | Capacity | | Length of Lines | | Fixtures | |
|---|---|---|---|---|---|---|---|
| Block | ( ) | 800 | ( ) | 150' | ( ) | No. of Baths | (1) |
| Precast | (X) | 900 | ( ) | 175' | ( ) | Dishwasher | ( ) |
| + BLOCKS | | 1000 | (X) | 200' | ( ) | Garbage Grdr. | ( ) |
| | | 1100 | ( ) | 225' | (X) | Auto-Washer | ( ) |
| | | 1200 | ( ) | 250' | ( ) | Other | |
| | | Other | | Other | | | |

NOTIFY HEALTH DEPARTMENT AT LEAST EIGHT HOURS BEFORE TANK IS TO BE INSPECTED.

Final Inspection 9-10-1963 Approved (✓) Disapproved ( )

Remarks

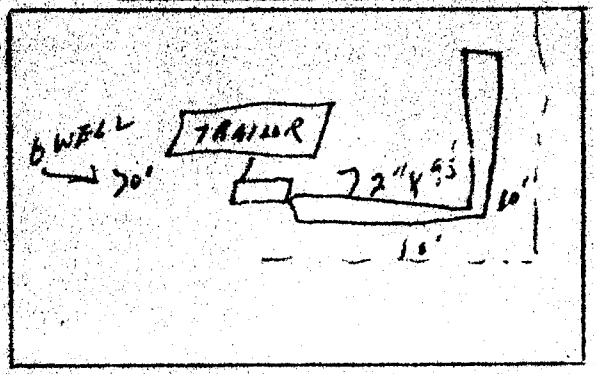


Sketch of Installation

JOB TURNED DOWN ON 9-7-63 THEN APPROVED ON 9-10-63

Raymond G. Thomas

Sanitarian