* Redraw. Replaces Permit issued 9-12-08

**IREDELL COUNTY HEALTH DEPARTMENT - ENVIRONMENTAL HEALTH** ☑ STATESVILLE OFFICE 704-878-5305 ☐ MOORESVILLE OFFICE 704-664-5281

**IMPROVEMENT PERMIT / AUTHORIZATION TO CONSTRUCT / OPERATION PERMIT / EXISTING SYSTEM INSPECTION**

PERMIT # 15211 PIN # 4865-88-1082 DATE 29 August 2011

OWNER Leah Ireland APPLICANT: Pilcher Enterprises Inc PHONE: Home/Cell # (336) 345-0380 Business #

SITE ADDRESS 371 Saw Mill Rd Hamptonville OWNER / APPLICANT ADDRESS

SITE DIRECTIONS Eagle Mill Rd. TR Saw Mill Rd - on Rt.

SUBDIVISION BLOCK / SECTION LOT # LOT AREA 9.03 ac. DESIGN FLOW 480 gpd L.T.A.R. 0.3 gpd/ft²

| | | | | | | | | | |
|---|---|---|---|---|---|---|---|---|---|
| Septic Tank 1000 | Gallons: STB 760 | Date 7-12-11 | ☑ New System | ☐ Repair | ☐ Expansion System | Type I II (III) IV V VI | ☑ Residence | No. Bedrooms 4 | Water Supply ☑ Private |
| Pump Tank | Gallons: P T | Date | System Description: 25% Reduction | | | | ☐ Business | No. Persons | ☐ Public |
| Pump Make | Model | Serial # | Repair System Description: 25% Reduction | | | | ☐ Other | No. Employees | ☐ Community |
| No. Nitrification Fields: 1 | No. Lines 3 | Linear Feet 400 | Maintenance Agreement Required ☐ YES ☑ NO | | | | ☐ Slab | ☐ Crawl Space | |
| Trench Width 36" | Max. Trench Bottom Depth 36" | | Gravel Depth NA | ☑ GRAVITY | ☐ PRESSURE | | ☐ Basement w/plumbing | ☑ Basement w/o plumbing | |


Comments / Conditions

* Keep well 100' from septic and Repair Areas.


Polylok Filter

ST HAS MARKER

INITIAL SITE SKETCH

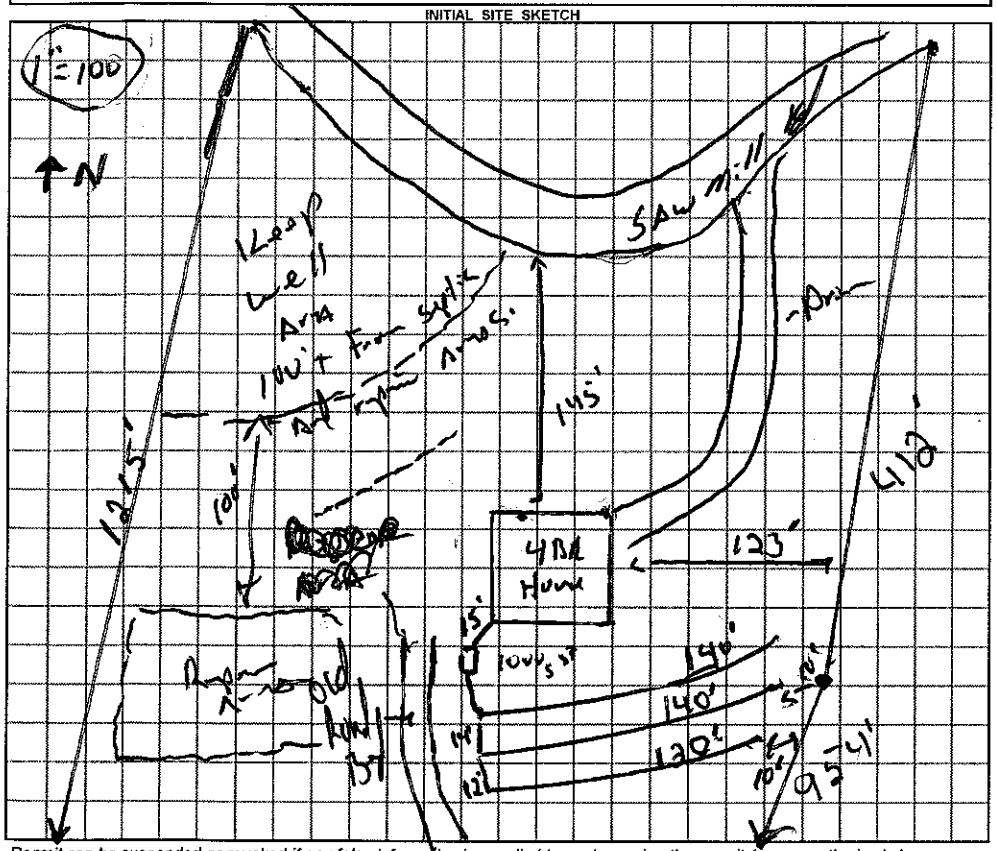


AS BUILT SKETCH

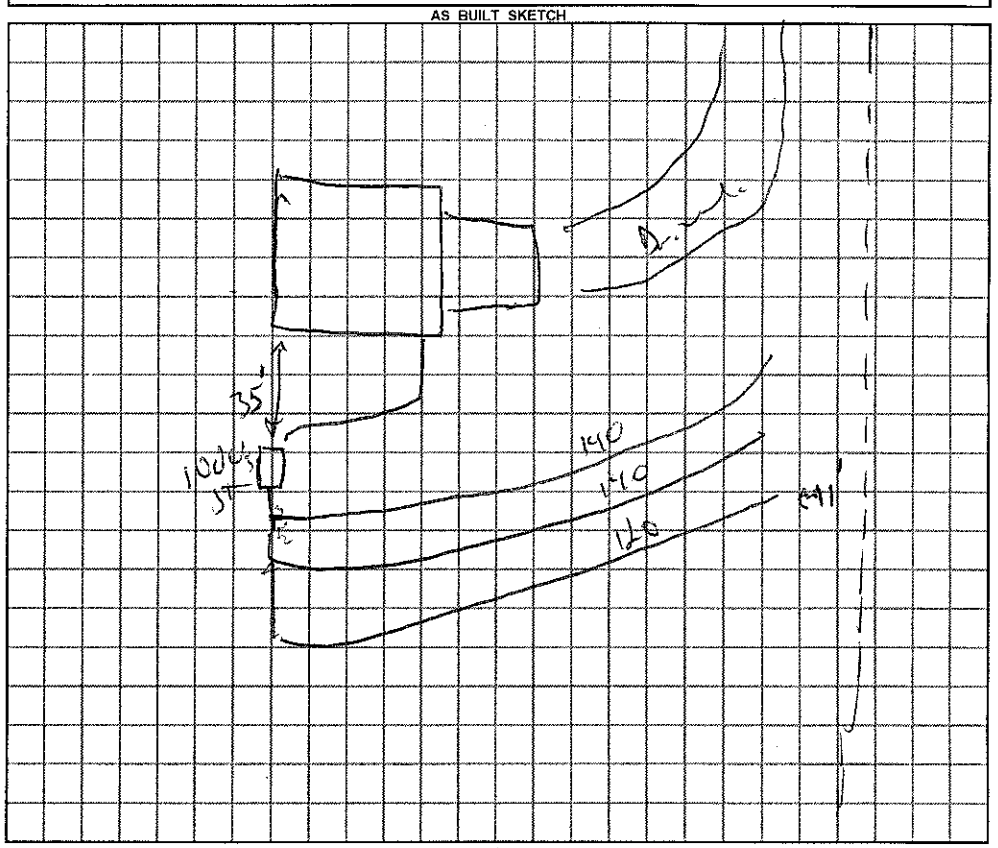


*Permit can be suspended or revoked if any false information is supplied toward securing the permit / any unauthorized changes are made to the site / any unauthorized changes are made in the installation of the system.*

☐ ***IMPROVEMENT PERMIT*** with plat valid without expiration. ☑ ***IMPROVEMENT PERMIT*** with ~~plat valid without expiration.~~ site plan valid 60 mo. ☑ ***AUTHORIZATION TO CONSTRUCT*** valid for period equal to IMPROVEMENT PERMIT--not to exceed 60 mo.

Owner / Applicant Signature: Date 1 Sept 11 Installed by: Darrell Salmons

IMPROVEMENT PERMIT by: REHS Date 29 Aug. 11 OPERATION PERMIT by: REHS Date 13 Dec 11

AUTHORIZATION TO CONSTRUCT by: REHS Date 29 Aug 11 Existing System Inspected by: REHS Date

***YOU SHOULD CONTACT A LOCATOR SERVICE PRIOR TO ANY EXCAVATION***

White Copy – Environmental Health YELLOW COPY (Final) Owner / Applicant PINK COPY (Initial) Owner / Applicant