# IREDELL COUNTY HEALTH DEPARTMENT

STATESVILLE 704-878-5305 MOORESVILLE 704-664-5281

## IMPROVEMENT PERMIT / AUTHORIZATION TO CONSTRUCT / OPERATION PERMIT / EXISTING SYSTEM INSPECTION

PERMIT# 137825 PIN# 4864001432 DATE 9-20-06

OWNER OR APPLICANT Ronald Cass PHONE: Business Home 704 682 8985

ADDRESS 281 Holland Farm Rd.

LOCATION 77N to (1) on 901, (R) on Union Grove ~ 2.5 miles (R) Holland Farm 281 on left

SUBDIVISION n/a BLOCK / SECTION n/a LOT Ex. LOT AREA Ex. SITE CLASS. Ex. DESIGN FLOW Ex L.T.A.R. EX

Septic Tank: Ex. Gallons: STB Ex. Date L

Pump Tank: Gallons: PT Date

Pump Make: Model Serial No.

Nitrification Field: No Fields Ex Square Feet Ex Linear Feet Ex

No Lines Ex Trench Width Ex Max Trench Bottom Depth Ex

☐ New System ☐ Repair ☐ Expansion System Type: I (II) III IV V VI

System Description: Existing

Repair System Description:

Maintenance Agreement Required: ☐ Yes ☐ No

☐ House/Mod. Home ☒ Mobile Home ☐ Business ☐ Other

No. Bedrooms 3 No. Persons No. Employees

Water Supply: ☒ Individual ☐ Public ☐ Community


Gravel Depth Ex ☒ Gravity ☐ Pressure ☐ Slab ☐ Crawl Space ☐ Basement w/plumbing ☐ Basement wo/plumbing

Comments:/Conditions:

Comments:/Conditions:

INITIAL SITE SKETCH

AS BUILT SKETCH

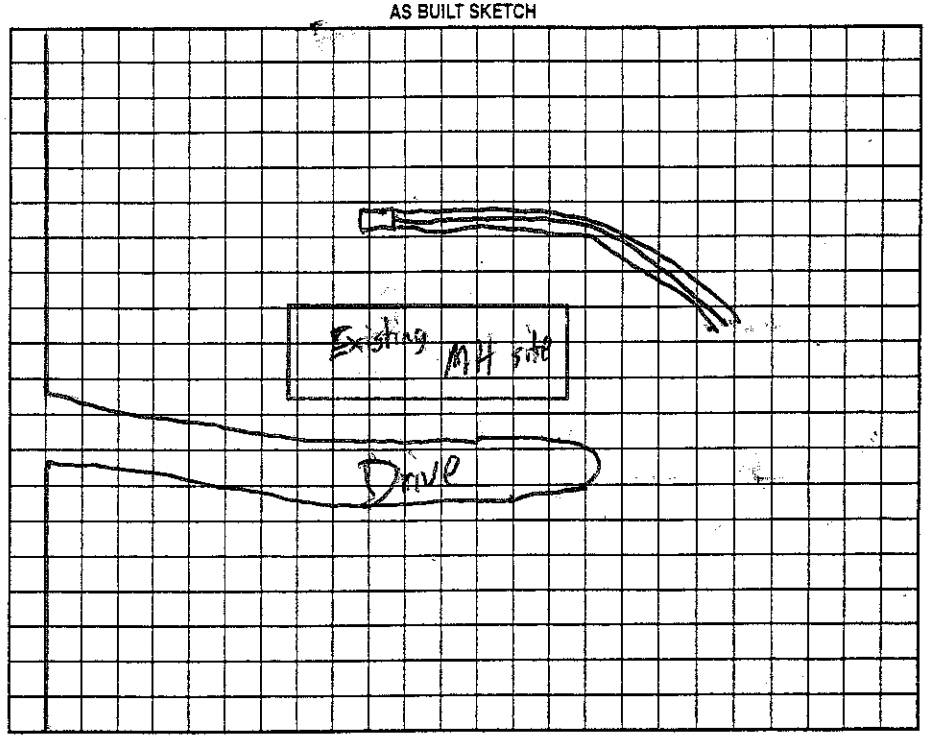


Permit can be suspended or revoked if any false information is supplied toward securing the permit/any unauthorized changes are made to the site/any unauthorized changes are made in the installation of the system. Improvement Permit with plat valid without expiration ☐ Improvement Permit with site plan valid for sixty months ☐ Authorization to Construct is valid for a period equal to that of Improvement Permit – not to exceed sixty months.

Signed: Ronald Cass date

Improvement Permit by: date

Authorization to Construct by: date

Installed by:

Operation Permit by: date

Existing System Inspection by: date 9-20-06

HEALTH DEPT. COPY: WHITE OWNER COPY (FINAL): YELLOW OWNER COPY (INITIAL): PINK